OFFICE OF THE MARION COUNTY SURVEYOR
SECTION RECORD CORNER
SECTION 24 TOWNSHIP 15 RANGE 4
DATE: 8-14-06
PARTY CHIEF: Wilcoxen
CREW:
TYPE OF MARKER: Harrison
METHOD OF ESTABLISHMENT: County: 5-30-01

IN. S.P.C. E ZONE NAD '83
NAME: 15042403
N: 498673.0818(m)
E: 69212.1326(m)

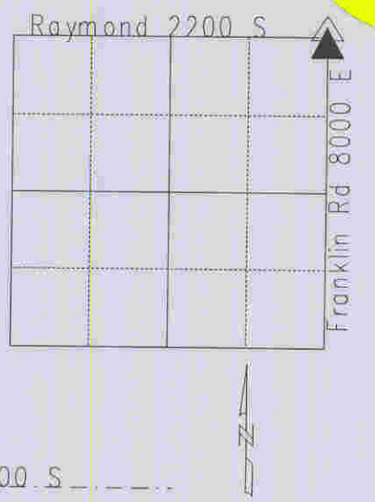

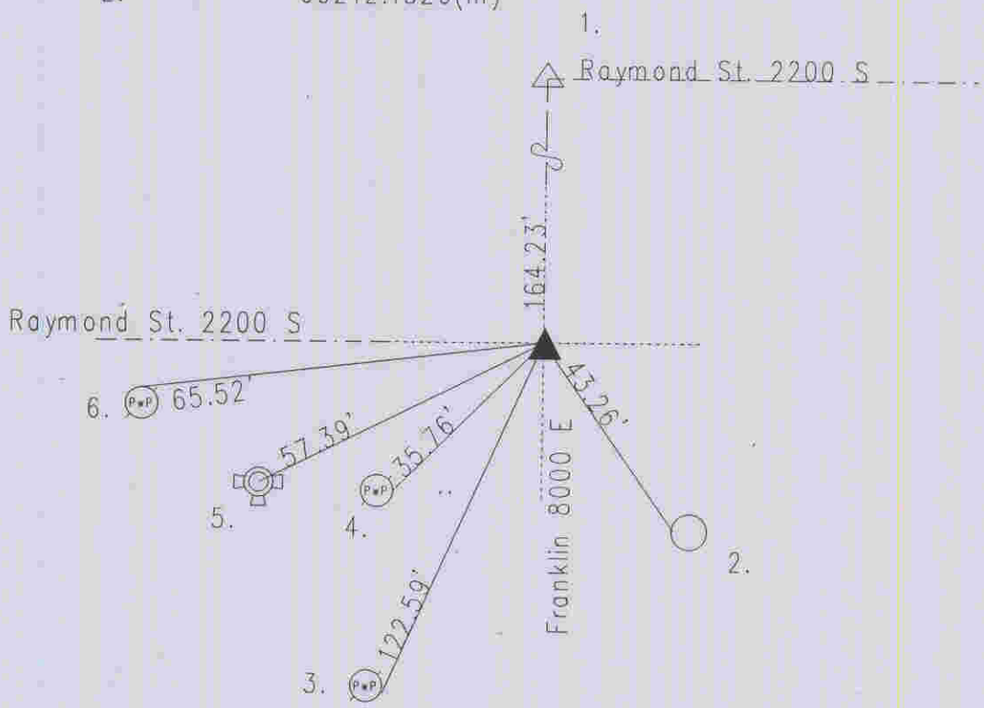

Original post set 1820 by Hendricks with witness: 18"beech N 79 W 38 links; 16" beech S 69 E 23 links per Marion County Atlas, pg. 10. No references per Wayne Township Legal Survey Book. 4-4-47 called stone 18" down. 7-20-59 called steel pin over stone. 6-12-75 called PK nail found at surface over steel pin, over stone. Excavated 7-14-87 stone found 30" down. Harrison set. Re-tied 10-15-96 by Kiste. Re-tied 5-30-01 by Kiste. Re-tied 8-14-06 by Wilcoxen. 15042403

REF.	DISTANCE	DESCRIPTION
1.	164.23'	Due N to NWQ 19-15-5 Harrison
2.	43.26'	PK nail W guy pole #168-620 12"up
3.	122.59'	Mag nail w/bw F PwP#22-619B 5"up
4.	35.76'	Mag nail w/bw F PwP#29-6-1 4"up
5.	57.39'	Top nut of fire hydrant
6.	65.52'	PK nail N PwP#30-619 B 10"up