OFFICE OF THE MARION COUNTY SURVEYOR
SECTION RECORD CORNER
SECTION 27 TOWNSHIP 15 RANGE 4
DATE: ~~5-30-01~~ 3-25-08
PARTY CHIEF: Wilcoxen
CREW:
TYPE OF MARKER: Mag nail w/washer set over stone
METHOD OF ESTABLISHMENT: County: 5-13-96

NOTE: This corner position represents a title corner and may not necessarily be in the position of the Record corner.

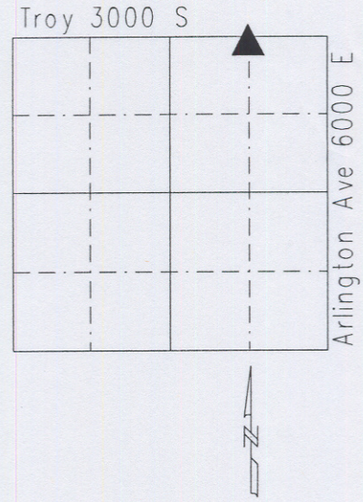

IN.S.P.C. E ZONE, NAD '83
Name: 15042711
N: 496962.8730(m)
E: 65560.3750(m)

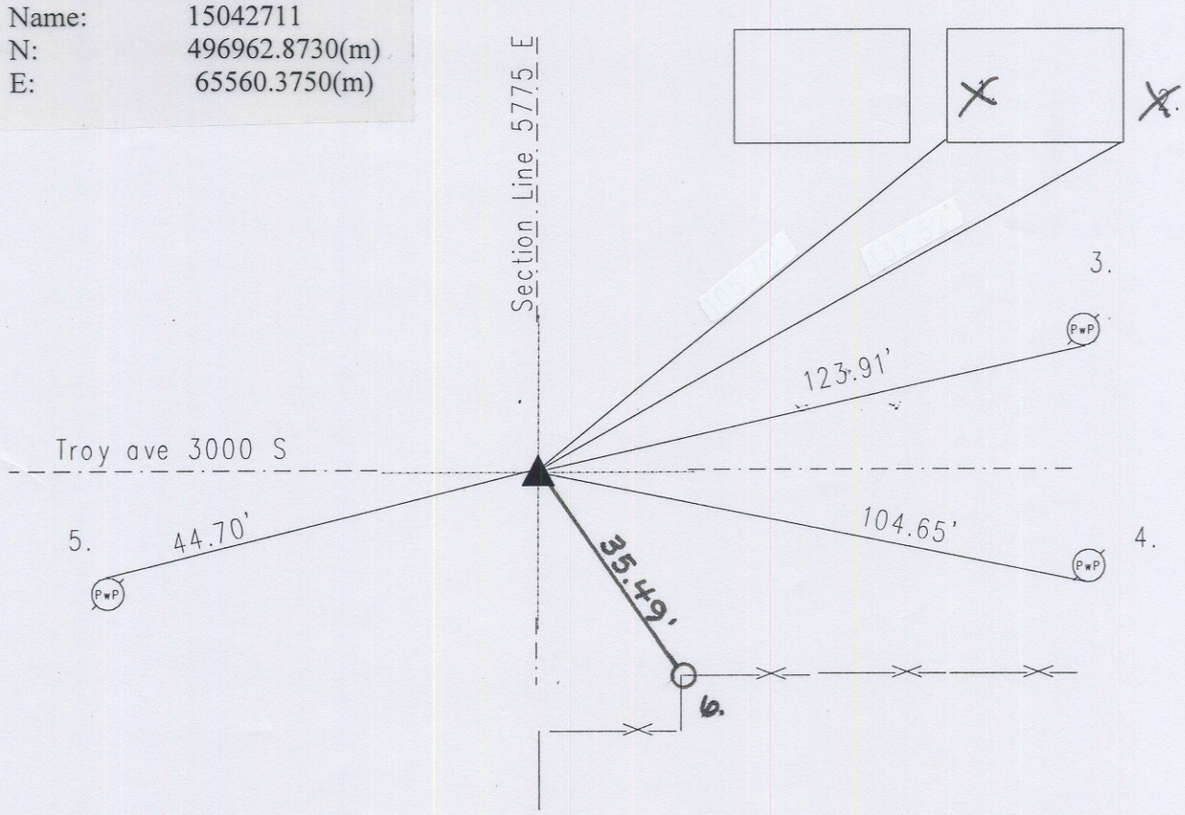

SX542711

REF.	DISTANCE	DESCRIPTION
1.	~~105.70'~~	~~SW corner of block building~~
2.	~~132.52'~~	~~SE corner of block building~~
3.	123.91'	PK nail S PwP#74-645A 4"up
4.	104.65'	PK nail S PwP#10-645 B 6"up
5.	44.70'	Mag nail w/bw N PwP#9-645 B 10"up
6.	35.49'	Face of steel corner fence post