OFFICE OF THE MARION COUNTY SURVEYOR
SECTION RECORD CORNER
SECTION 29 TOWNSHIP 15 RANGE 4
DATE: ~~3-05-01~~ 9-4-07
PARTY CHIEF: Wilcoxen
CREW:
TYPE OF MARKER: Copperweld cut 'x' fd
METHOD OF ESTABLISHMENT: County: 7-24-96

NOTE: This corner position represents a title corner and may not necessarily be in the position of the Record corner.

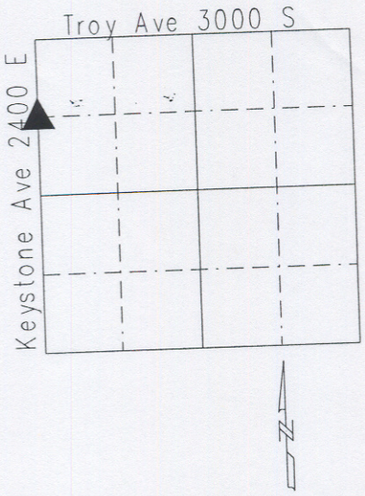

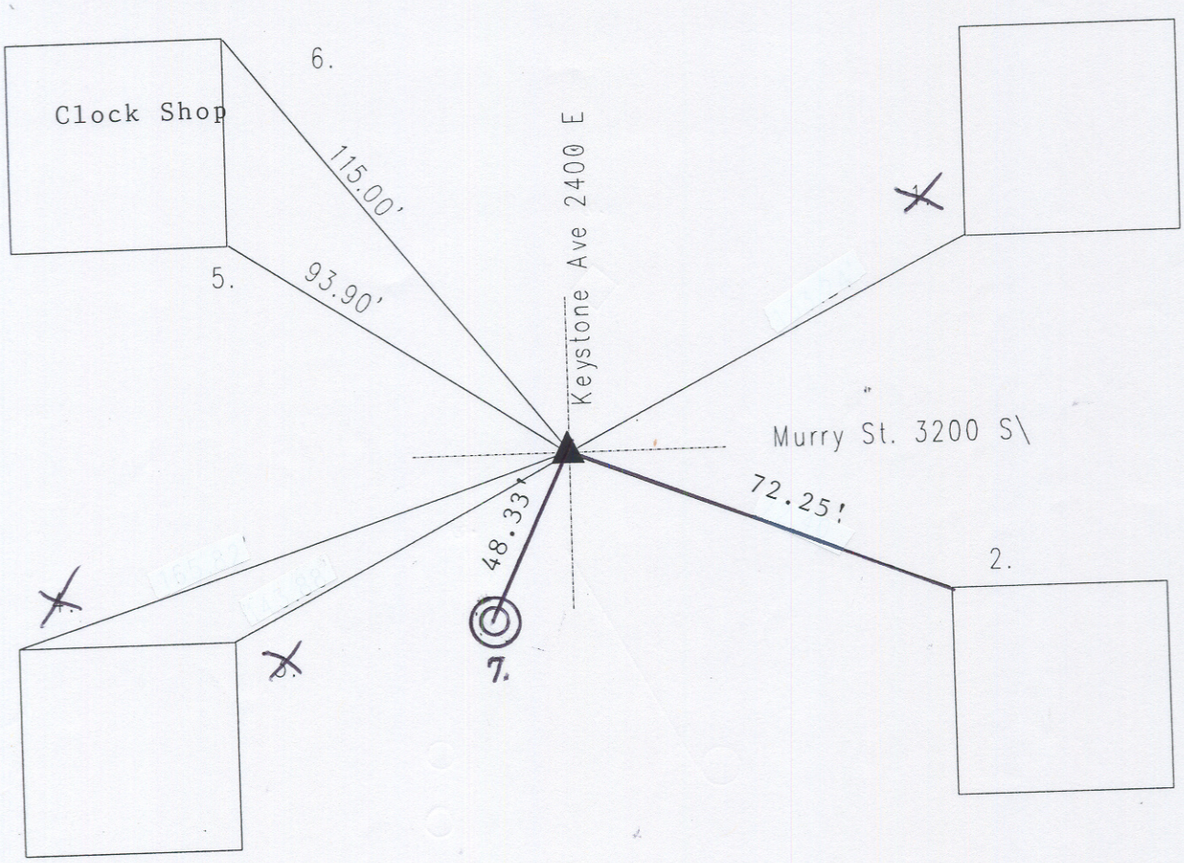

SX542912

REF.	DISTANCE	DESCRIPTION
1.	133.24'	~~SW corner of one-story foundation 8"up~~
2.	72.25'	NW corner of one-story foundation 6"up
3.	~~143.88'~~	~~NE corner of filling station 8"up~~
4.	~~165.82'~~	~~NW "~~
5.	93.90'	SE corner of concrete block 4"up
6.	115.00'	NE corner "
7.	48.33'	Center 'x' in sewer manhole