OFFICE OF THE MARION COUNTY SURVEYOR

SECTION RECORD CORNER

SECTION 30 TOWNSHIP 15 RANGE 4

DATE: ~~5-30-01~~ 9-4-07

PARTY CHIEF: ~~Kiste~~ Wilcoxen

CREW: Quarter-corner

TYPE OF MARKER: ~~C/L~~ monument ~~set~~ fd

METHOD OF ESTABLISHMENT: ~~County:~~ 7-12-96

NOTE: This corner position represents a title corner and may not necessarily be in the position of the Record corner.

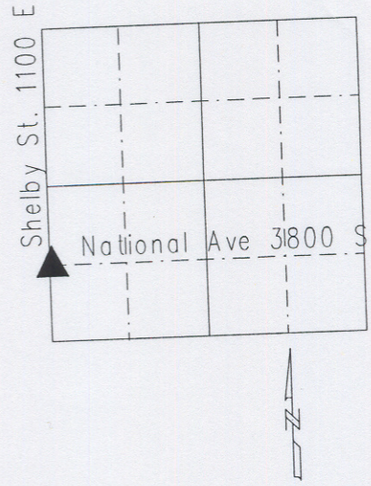

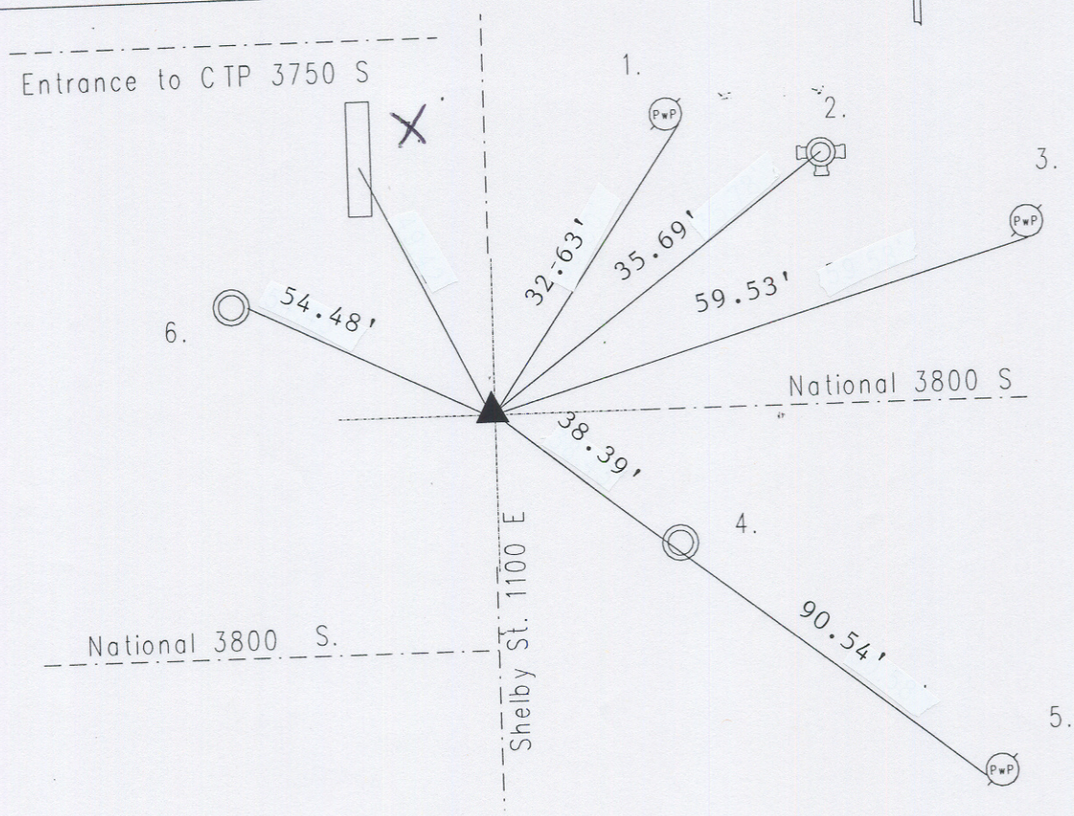

SX543019

REF.	DISTANCE	DESCRIPTION
1.	32.63'	Road nail SE PwP#22-668A 1"up
2.	35.69'	Top nut of fire hydrant
3.	59.53'	Road nail S PwP#164-668 A 36"up
4.	38.39'	Cut 'x' W-rim of manhole
5.	90.54'	PK nail SW PwP#324-668 A 10"up
6.	54.48'	Cut 'x' E-rim manhole
7.		~~Cut 'x' inside of corner of inlet~~