OFFICE OF THE MARION COUNTY SURVEYOR
SECTION RECORD CORNER
SECTION 33 TOWNSHIP 15 RANGE 4
DATE: 6-30-06
PARTY CHIEF: Wilcoxen
CREW:
TYPE OF MARKER: Harrison
METHOD OF ESTABLISHMENT: County: 3-20-01

IN. S.P.C. E ZONE NAD '83
NAME: 15043302
N: 495291.0040(m)
E: 63523.8220(m)

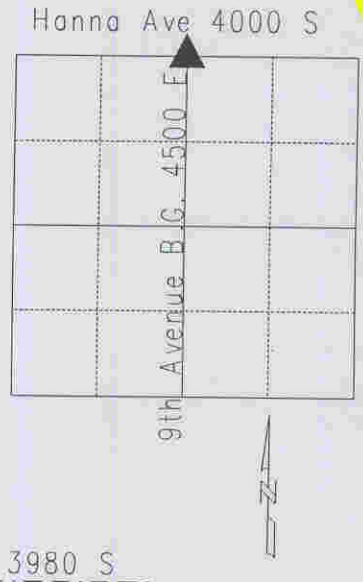

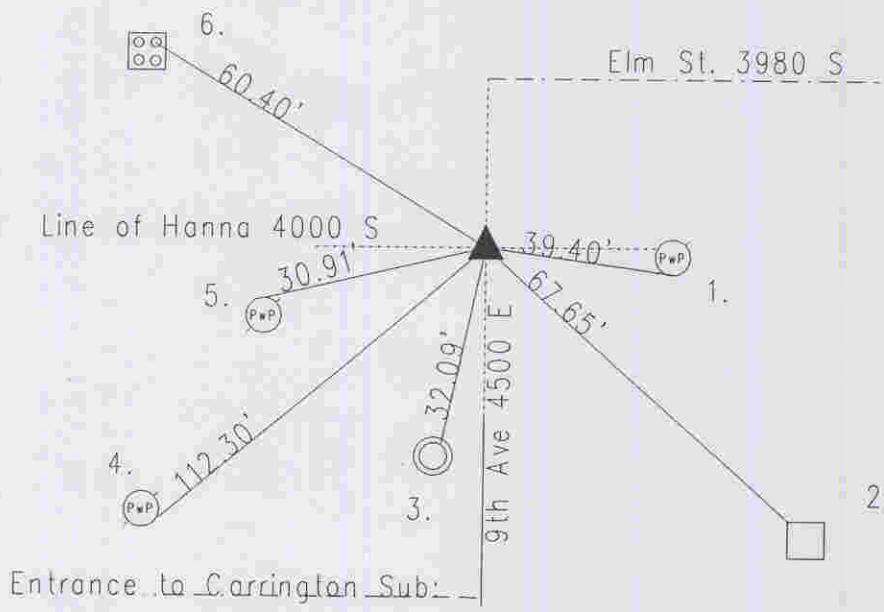

Original post set 1820 by Hendricks with witness: 15" beech N 56 E 16 links; 18" dogwood S 48 W 8 links per Marion County Atlas pg. 10. Fatout 8-29-1876 called a rock set with witness: 8" wild cherry N 22 E 52 1/2 links per Perry Township Legal Survey Book pg. 69. 8-6-47 MCSO called stone. Monroe 10-7-60 called steel pipe. McLand 3-1-74 called PK nail. Wilcoxen 10-20-75 called road nail. Greene 10-4-88 called road nail. Excavated per Kiste 7-23-96 Harrison set. Re-tied 3-20-01 by Whiteside. Re-tied 6-30-06 by Wilcoxen.

15043302

REF.	DISTANCE	DESCRIPTION
1.	39.40'	Mag nail w/bw S PwP#33-673A 18"up
2.	67.65'	Cut 'x' northwesterly corner of brace bolt "Hi-line Tower"
3.	32.09'	Cut 'x' F-rim of bell manhole
4.	112.30'	Mag nail w/bw SF PwP#123-672B 10"up
5.	30.91'	PK nail N PwP#116-72 B 12"up
6.	60.40'	Cut 'x' NF bolt of signal pole base