OFFICE OF THE MARION COUNTY SURVEYOR

SECTION RECORD CORNER

SECTION 35 TOWNSHIP 15 RANGE 4

DATE: 6-17-03

PARTY CHIEF: Wilcoxen

CREW:

TYPE OF MARKER: Mag nail w/brass washer set over bolt

METHOD OF ESTABLISHMENT: County: 6-4-98

NOTE: This corner position represents a title corner and may not necessarily be in the position of the Record corner.

IN.S.P.C. E ZONE, NAD '83

Name: 15043511

N: 495380.6810(m)

E: 67180.2830(m)

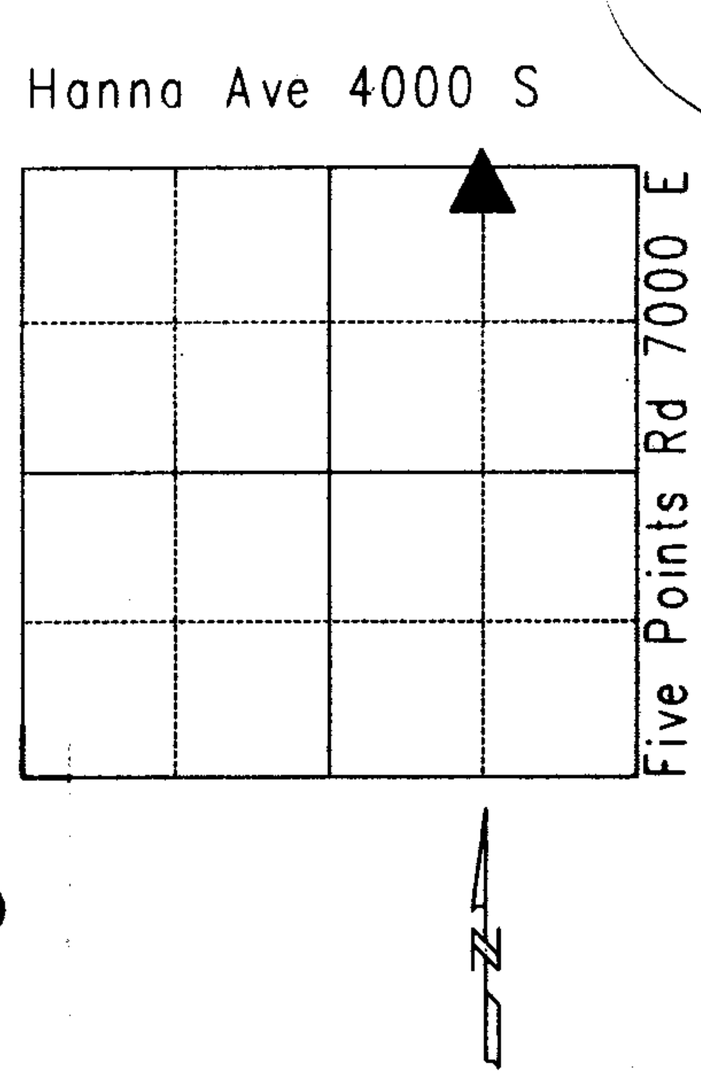

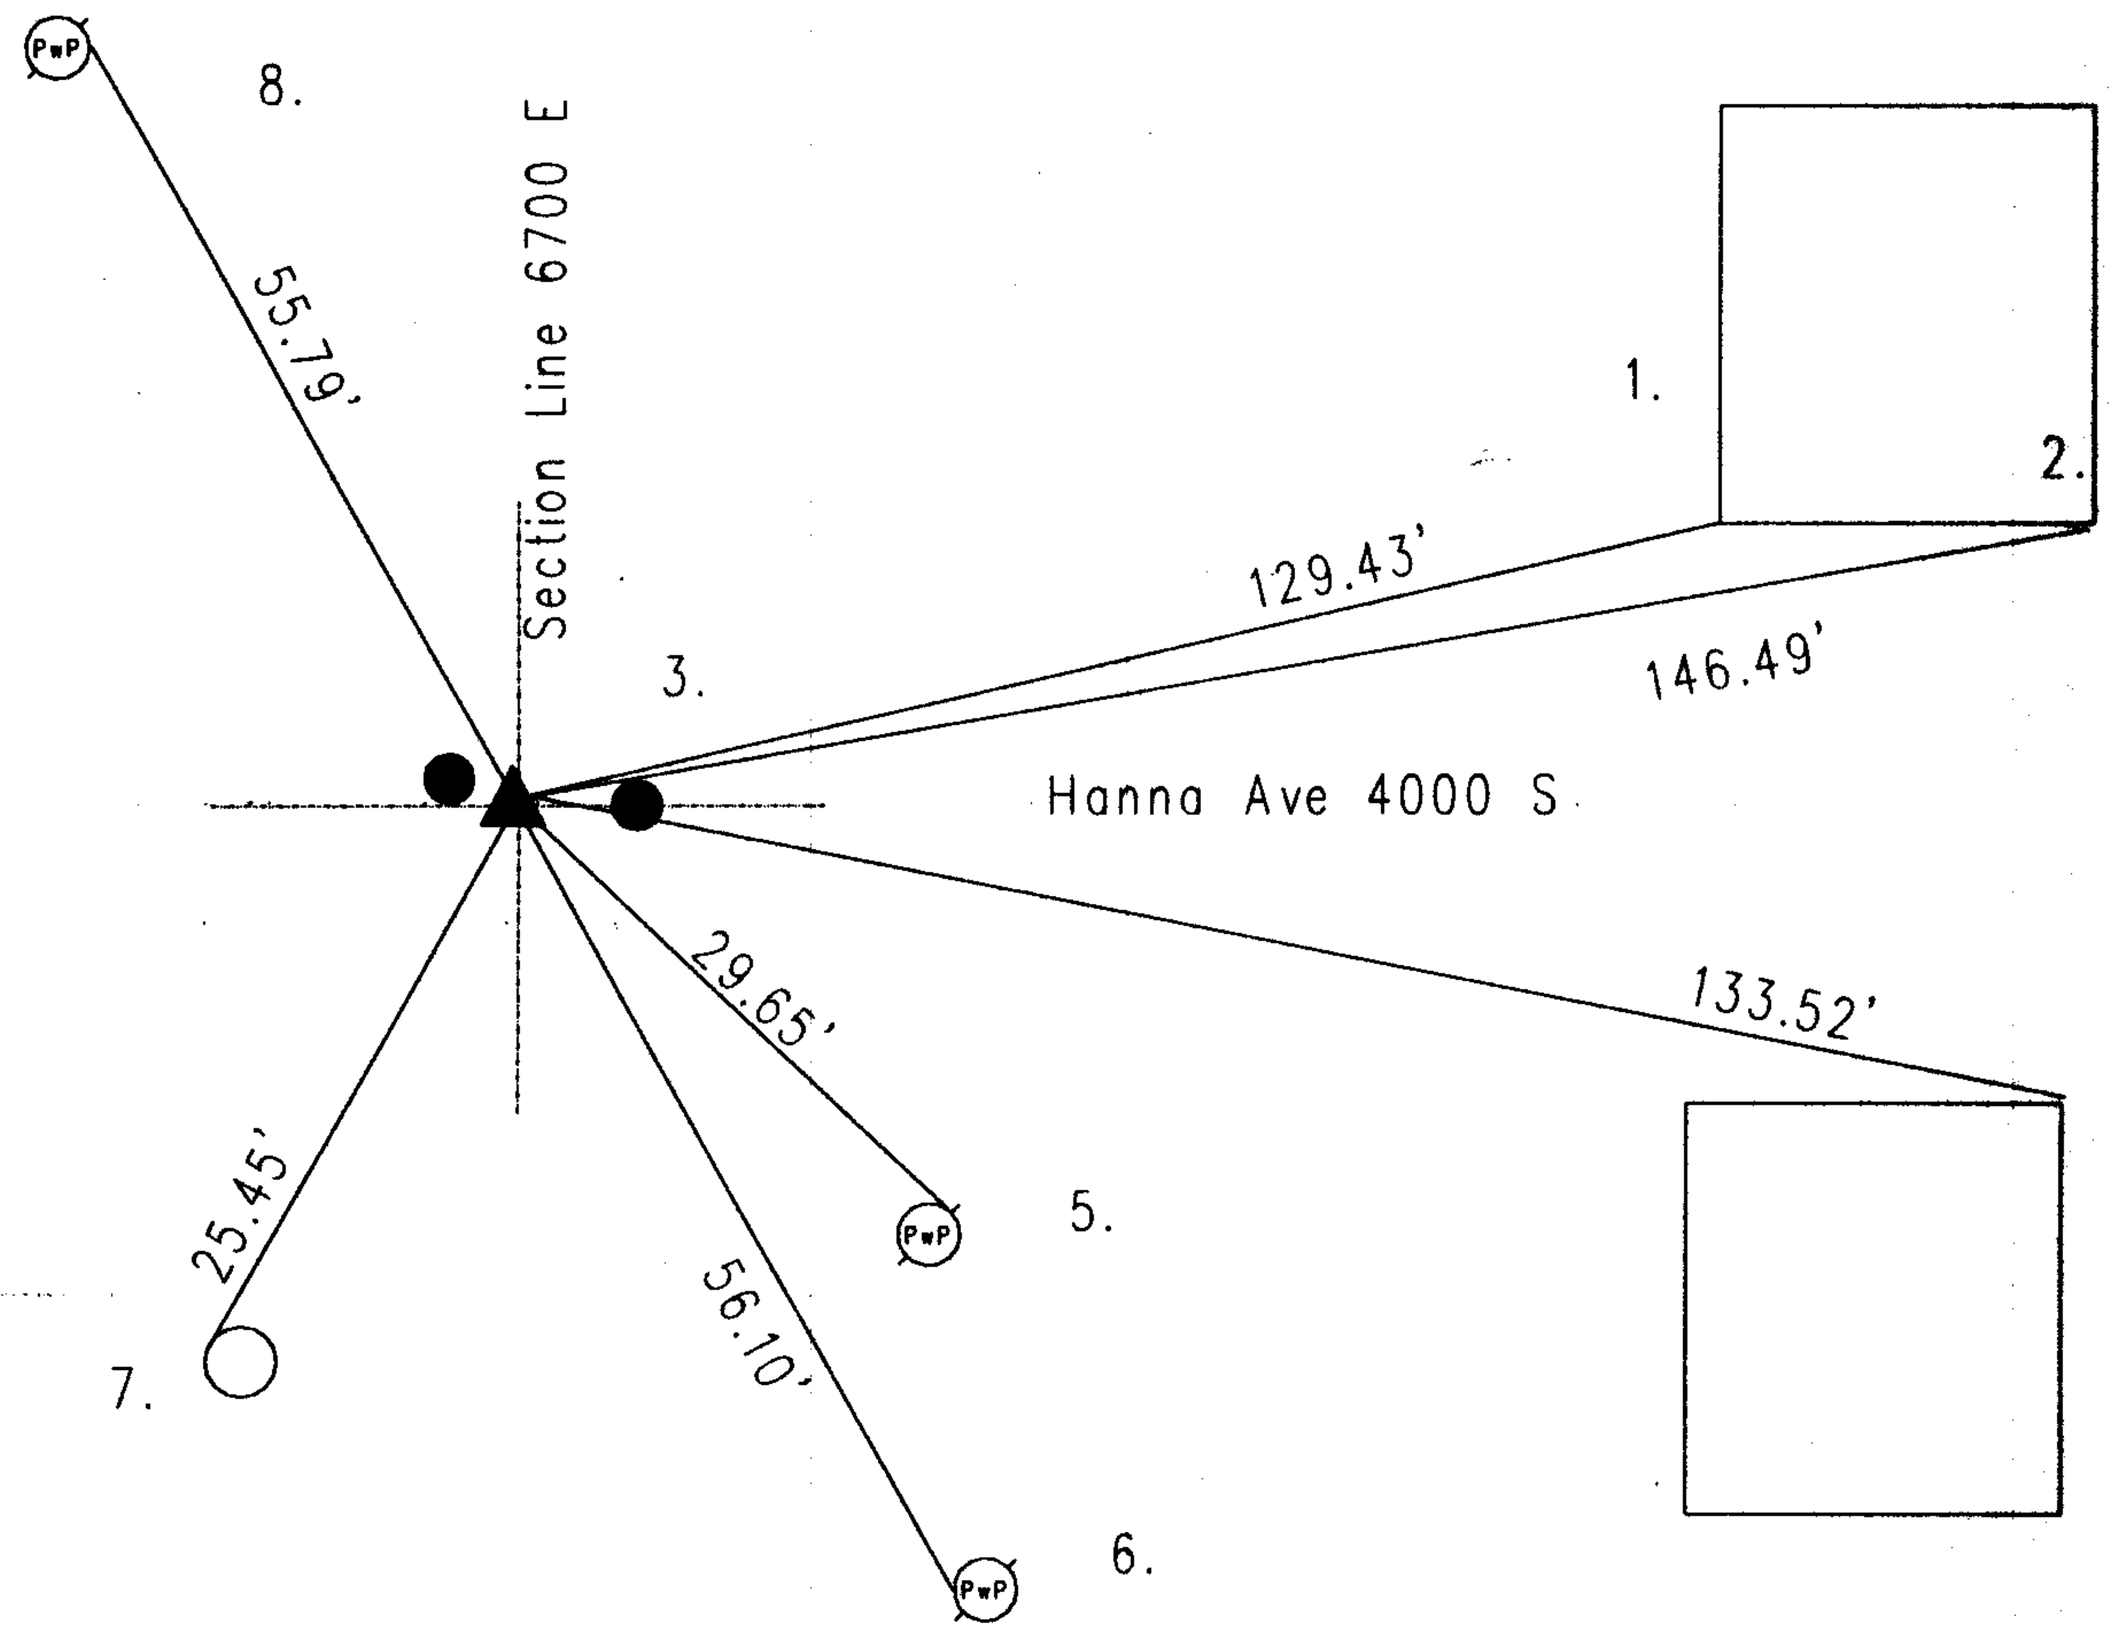

SX543511

REF.	DISTANCE	DESCRIPTION
1.	129.43'	SW corner of one story brick & frame ADDRESS 6736
2.	146.49'	SE "
3.	15.42'	Large road nail E of point
4.	133.52'	NE corner 1 1/2 story brick & frame
5.	29.65'	PK nail w/brass washer NE PwP#79-677 b 12"up
6.	56.10'	Found PK nail W PwP#80-677 15"up
7.	25.45'	Found road nail W fence post 12"up
8.	55.79'	PK nail w/brass washer E PwP#130-677 A 10"up
9.	0.92' W	Distance due W
	0.6'N	Distance due N rebar found