OFFICE OF THE MARIÓN COUNTY SURVEYOR
SECTION RECORD CORNER
SECTION 15 TOWNSHIP 15 RANGE 5
DATE: 7-30-07
PARTY CHIEF: Wilcoxen
CREW:
TYPE OF MARKER: Survey marker nail set over
METHOD OF ESTABLISHMENT: County: brass plug w/Oct. disc 2" down
IN. S.P.C. E ZONE NAD '83
NAME: 15051503
N: 500421.0972(m)
E: 75530.7610(m)

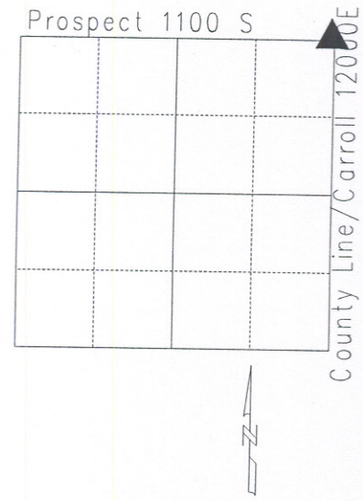

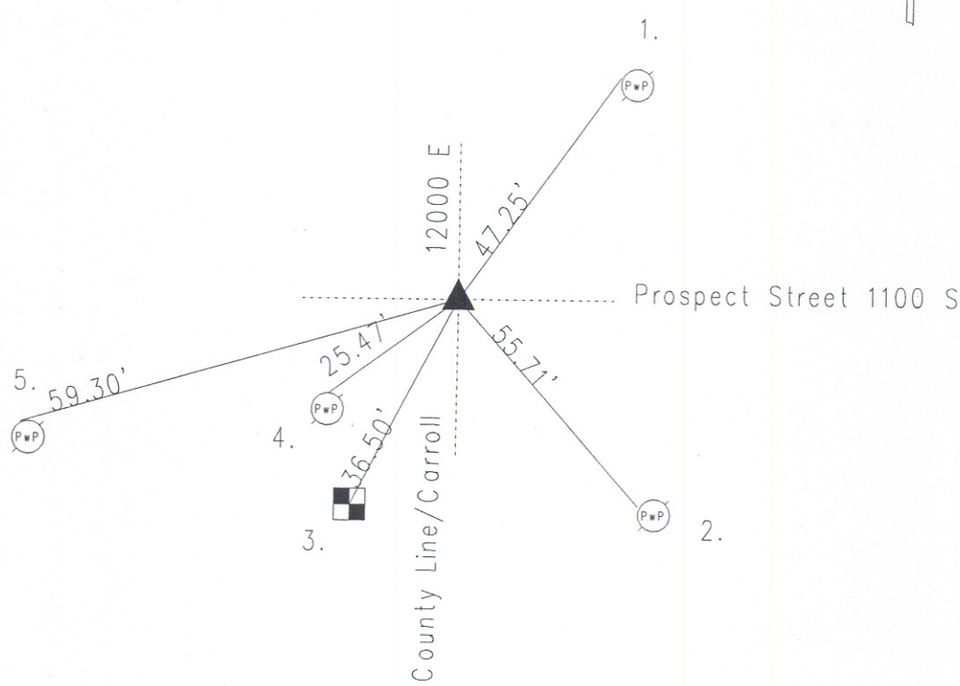

15051503

REF.	DISTANCE	DESCRIPTION
1.	47.25'	PK nail W PwP#125-581GA 10"up
2.	55.71'	PK nail W PwP#16-581B 14"up
3.	36.50'	Benchmark USC & GS (MSCO 7001 elev. 249.805 meters)
4.	25.47'	Mag nail w/bw NW PwP#73-581F 3"up
5.	59.30'	PK nail N PwP#19-581 F 10"up