OFFICE OF THE MARION COUNTY SURVEYOR
SECTION RECORD CORNER
SECTION 16 TOWNSHIP 15 RANGE 5
DATE: 2-22-05
PARTY CHIEF: Wilcoxen
CREW:
TYPE OF MARKER: Rebar found @ NW corner
METHOD OF ESTABLISHMENT: County: 4-29-00

IN. S.P.C. E ZONE NAD '83
NAME: 15051605
N: 499574.6140(m)
E: 73120.3088(m)

NOTE: This corner position represents a title corner and may not necessarily be in the position of the Record corner.

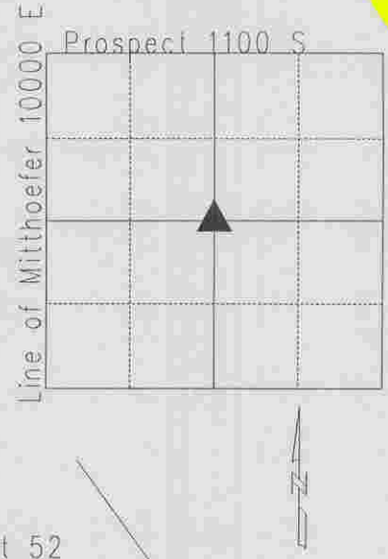


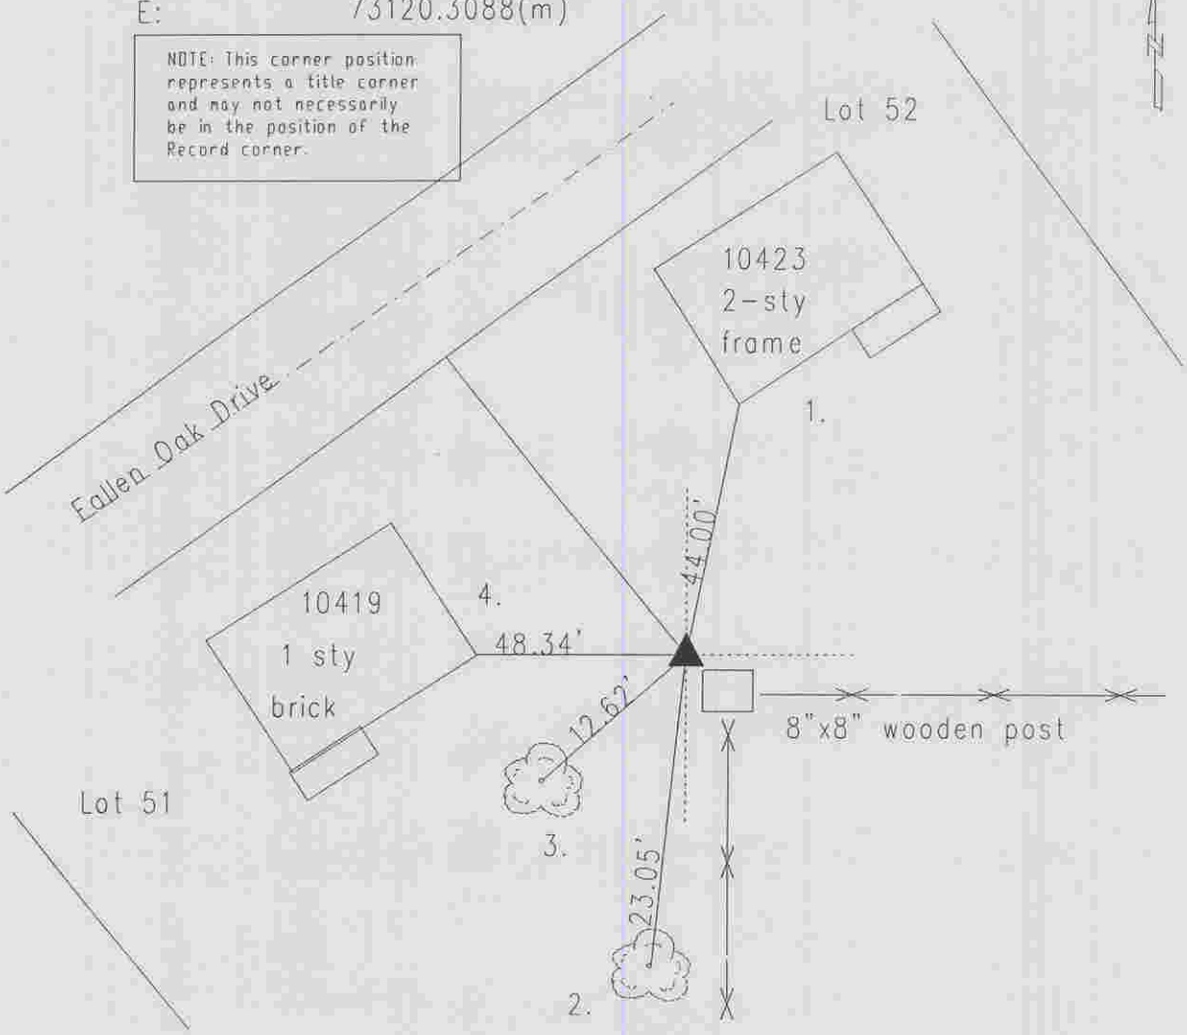


| REF. | DISTANCE | DESCRIPTION |
|---|---|---|
| 1. | 44.00' | Northeast to Southerly corner of ADDRESS 10423 wood siding |
| 2. | 23.05' | Mag nail w/washer W 24" twin ash 12"up |
| 3. | 12.62' | Mag nail w/washer SW 18" maple 12"up |
| 4. | 48.34' | Due W to Easterly corner of ADDRESS 10419 brick |