OFFICE OF THE MARION COUNTY SURVEYOR
SECTION RECORD CORNER
SECTION 29 TOWNSHIP 15 RANGE 5
DATE: ~~9-17-98~~ 9-2-03
PARTY CHIEF: Wilcoxen
CREW:
TYPE OF MARKER: Harrison 3" dn
METHOD OF ESTABLISHMENT: County: 1-20-93

IN. S.P.C. E ZONE, NAD 83
NAME: 15052902
N: 497115.9310(m)
E: 71500.0580(m)

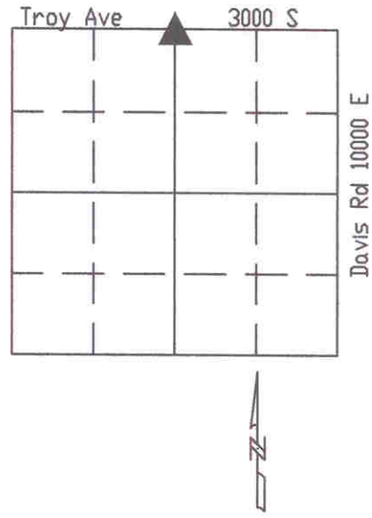

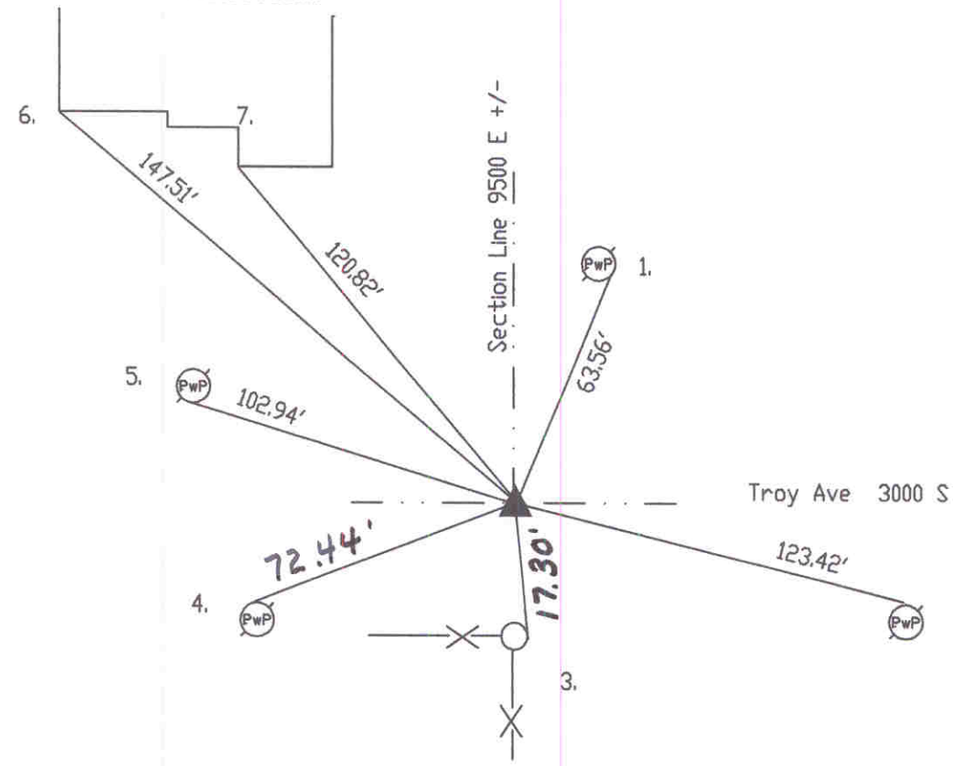

Original post set 1820 by Hendricks with witnesses: 5" beech N 16 E 9 links, 12" sugar S 35 E 9 links per Marion County Atlas pg. 14. Hosbrook 4-3 & 4-4-1855 called no stone but witness: 30" oak N 10 W 31 links, and 5" beech S 7 1/2 E 41 links per Franklin Township Legal Survey Book pg. 7. Baden 1-4-56 called exposed stone. Fortner 2-13-75 called PK nail. 12-8-75 Wilcoxen called same. Cleveland 4-30-80 called same. Gries 11-10-87 called same. Wilcoxen excavated 12-21-92 PK nail fd 2" dn, 1/2" rebar fd 8" dn. Harrison set. re-tied 9-17-98 by Wilcoxen.

HC552902

REF.	DISTANCE	DESCRIPTION
1.	63.56'	PK E light pole 4.5' up
2.	123.42'	PK w/brass washer N PwP#1-651BB 12"up
3.	17.30'	~~PK w/brass~~ washer E fence post 12"up
4.	72.44'	~~PK w/shiner~~ N PwP#25-651AB 8"up (Mag nail)
5.	102.94'	PK w/shiner S PwP#13-651AA 4"up (Mag nail)
6.	147.51'	SW corner of House #9442
7.	120.82'	SW corner of House #9442