c

OFFICE OF THE MARION COUNTY SURVEYOR
SECTION RECORD CORNER
SECTION 32 TOWNSHIP 15 RANGE 5
DATE: 3-5-93
PARTY CHIEF: Wilcoxen
CREW:
TYPE OF MARKER: Stone Fd w/'x'
METHOD OF ESTABLISHMENT: Legal Survey

THIS CORNER POSITION REPRESENTS A "TITLE" CORNER AND MAY NOT NECESSARILY REPRESENT THE POSITION BASED ON RECORD CORNERS.

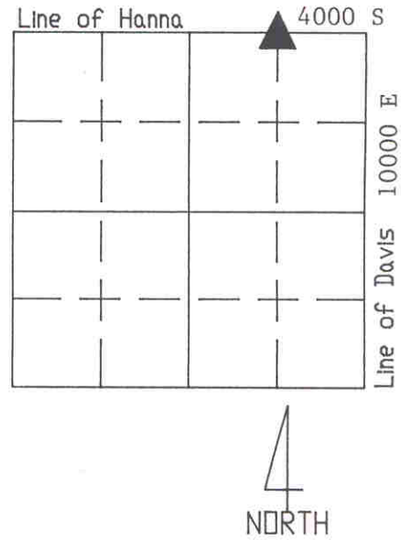

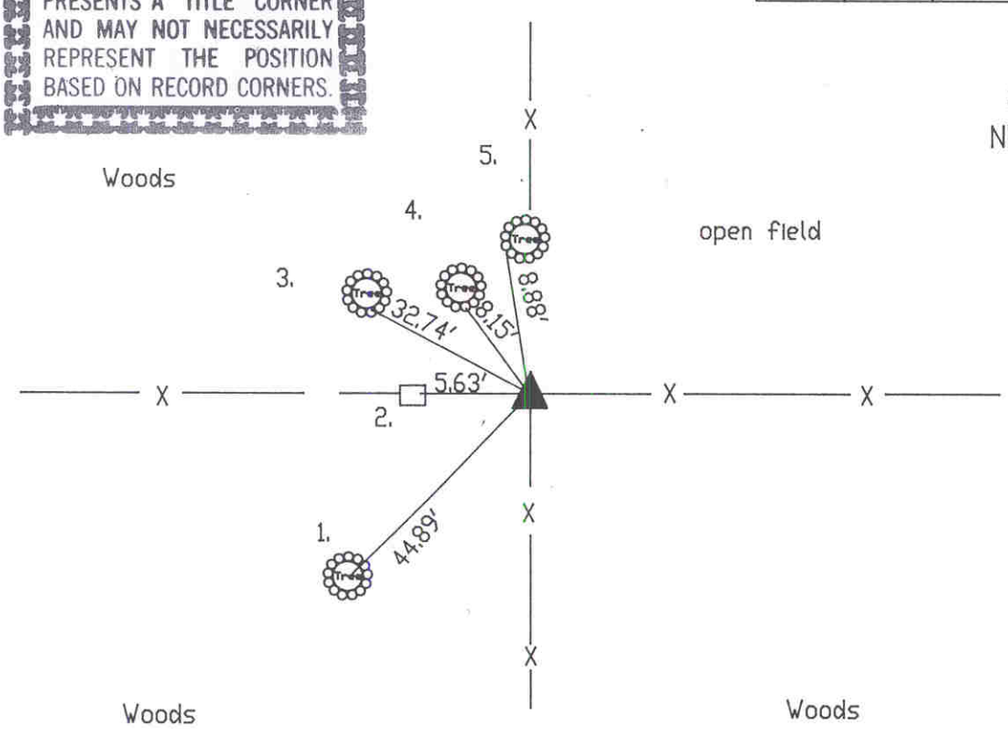

SX553211

REF.	DISTANCE	DESCRIPTION
1.	44.89'	PK w/shiner 40" twin ash 2"up
2.	5.63'	Due W to PK N f.p. 2"up
3.	32.74'	PK w/shiner S 10" ash 3"up
4.	8.15'	PK w/shiner NE spur root 24"ash
5.	8.88'	PK w/shiner W 8" aswh 2" up