OFFICE OF THE MARION COUNTY SURVEYOR
SECTION RECORD CORNER
SECTION 32 TOWNSHIP 15 RANGE 5
DATE: 9-3-3
PARTY CHIEF: Wilcoxen
CREW:
TYPE OF MARKER: Mag nail found
METHOD OF ESTABLISHMENT: County: 11-10-87

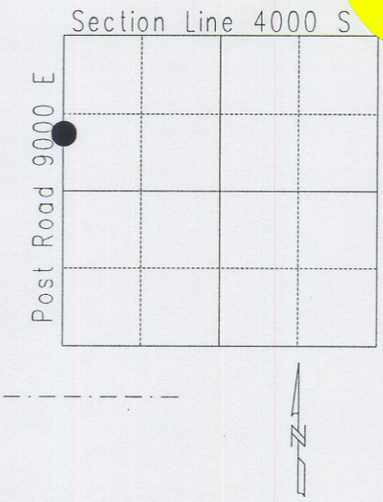

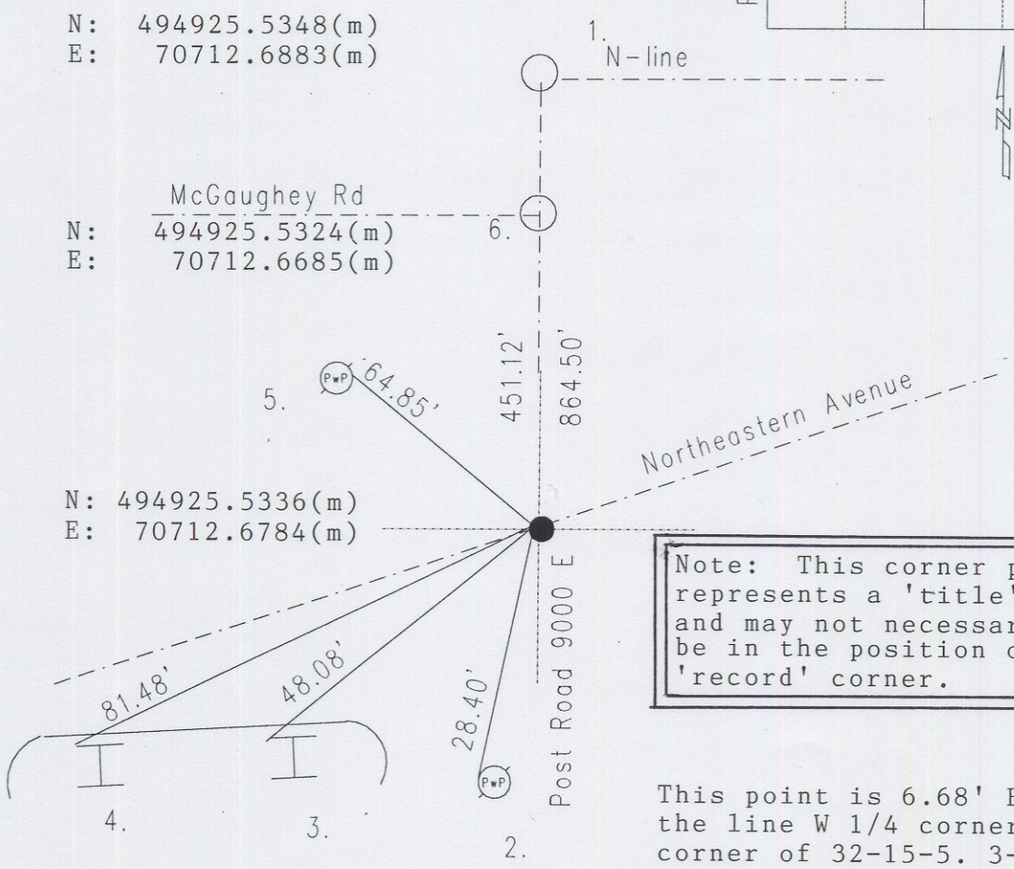

Note: This corner position represents a 'title' corner and may not necessarily be in the position of the 'record' corner.

This point is 6.68' East of the line W 1/4 corner to NW corner of 32-15-5. 3-13-08.

PX5532A

REF.	DISTANCE	DESCRIPTION
1.	864.50'	Due N to N line of Brown's North Park Add
2.	28.40'	Mag nail w/brass washer W PwP#14-681 AB 6"up
3.	48.08'	NW corner of I-beam post
4.	81.48'	NW corner of I-beam post
5.	64.85'	Mag nail w/brass washer E PwP#124-681 B 6"up
6.	451.12'	Due N to McGaughy Road