OFFICE OF THE MARION COUNTY SURVEYOR
SECTION RECORD CORNER
SECTION 9 TOWNSHIP 16 RANGE 2
DATE: 10-17-05
PARTY CHIEF: Kiste
CREW:
TYPE OF MARKER: PK over PK over I. P.
METHOD OF ESTABLISHMENT: County: 9-26-74

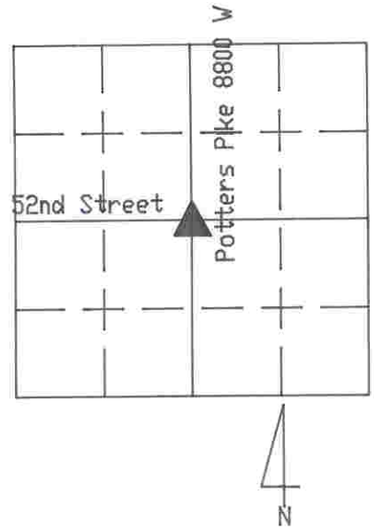

NOTE: This corner position represents a title corner and may not necessarily be in the position of the Record corner.

IN.S.P.C. E ZONE, NAD 83
NAME: 16020905
N: 510479.6705(m)
E: 44231.5363(m)

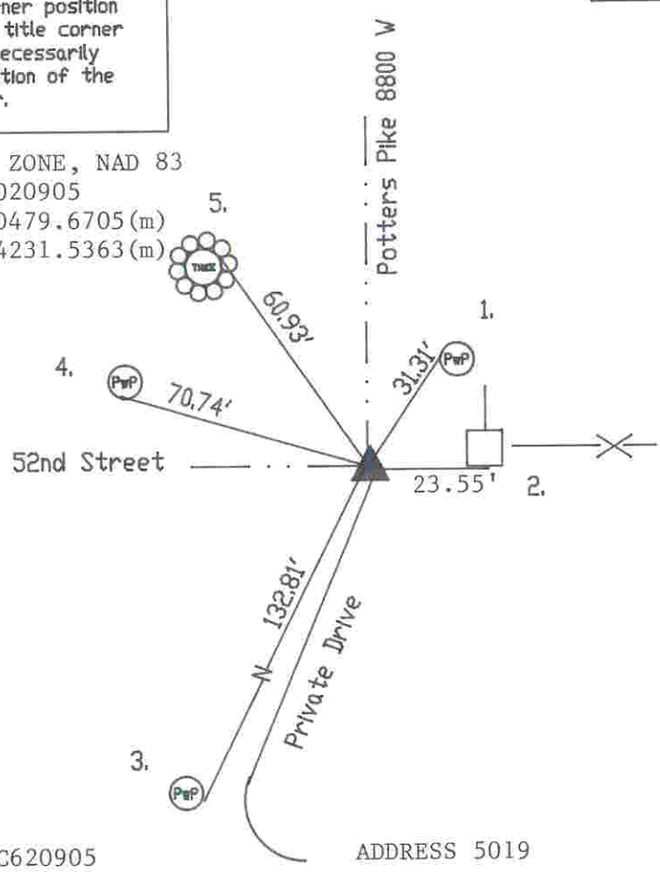

SC620905 ADDRESS 5019

REF.	DISTANCE	DESCRIPTION
1.	31.31'	RR W PwP#44-321XB 3"up
2.	23.55' ~~23.55'~~	Rd S wooden f.p. 12"up
3.	132.81'	PK E PwP#60-351WA 6"up
4.	70.74'	PK S PwP#115-321XB 10"up
5.	60.93'	PK w/washer NE 20" cherry 4"up