The OFFICE of the MARION COUNTY SURVEYOR

SECTION CORNER RECORD
MARION COUNTY, INDIANA

Sec. 16 Twp. 16 Range 2

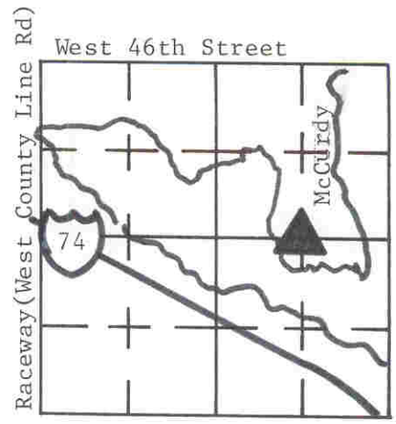

DATE: 9 - 13 - 85

CREW: P.C.- Green

INST. - Greene ROD. -

TYPE of MARKER: FD stone COND. of MARKER: Good:

METHOD of ESTABLISHMENT: County Ties dated 2/6/75; re-checked 9/13/85

THIS CORNER POSITION REPRESENTS A "TITLE" CORNER AND MAY NOT NECESSARILY BE IN THE POSITION OF THE RECORD CORNER.

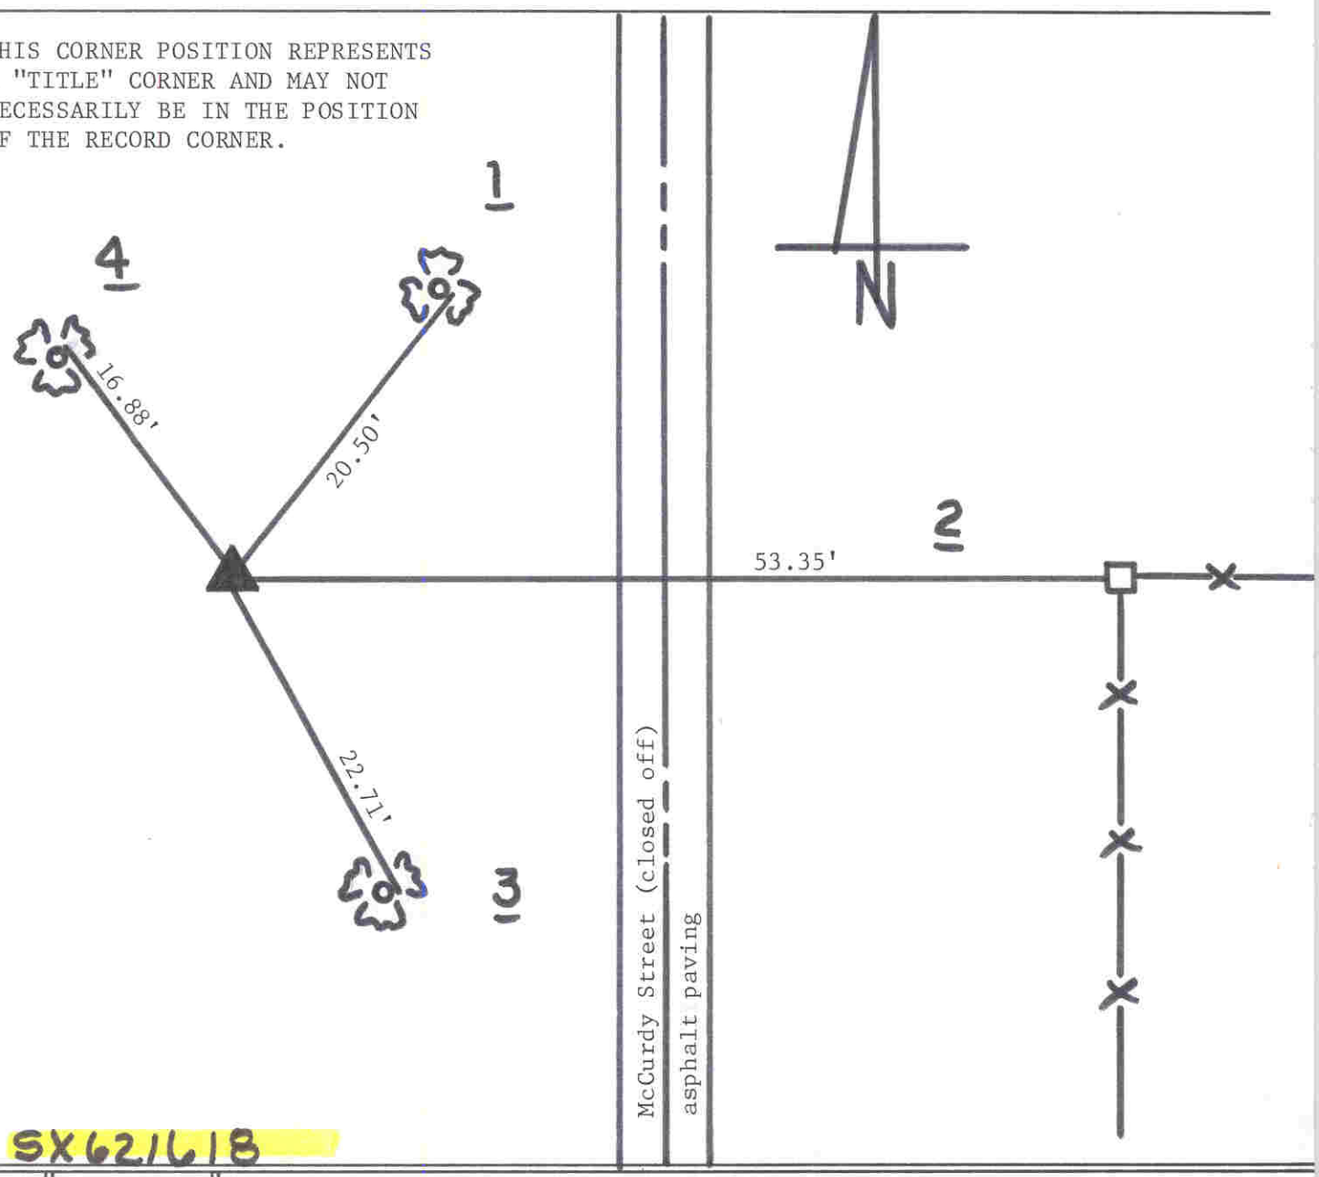

SX621618

REFERENCE	DISTANCE	DESCRIPTION	
1	20.50	RR spike Fnd. SE-side of 14" Sycamore Tree;	24"up
2	53.35	Nail in bottle cap W-side of fence post;	6"up
3	22.71	RR spike Fnd. E-side of Twin 14" Oak Tree;	18"up
4	16.88	PK nail in NE-side of 18" Wild Cherry Tree;	30"up