OFFICE OF THE MARION COUNTY SURVEYOR
SECTION RECORD CORNER
SECTION 21 TOWNSHIP 16 RANGE 2
DATE: ~~4-15-02~~ 9-13-07
PARTY CHIEF: Wilcoxen
CREW:
TYPE OF MARKER: Survey marker nail shaft fd
METHOD OF ESTABLISHMENT: County: 8-2-96

NOTE: This corner position represents a title corner and may not necessarily be in the position of the Record corner.

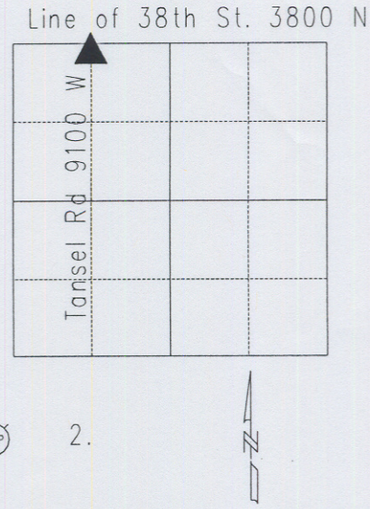

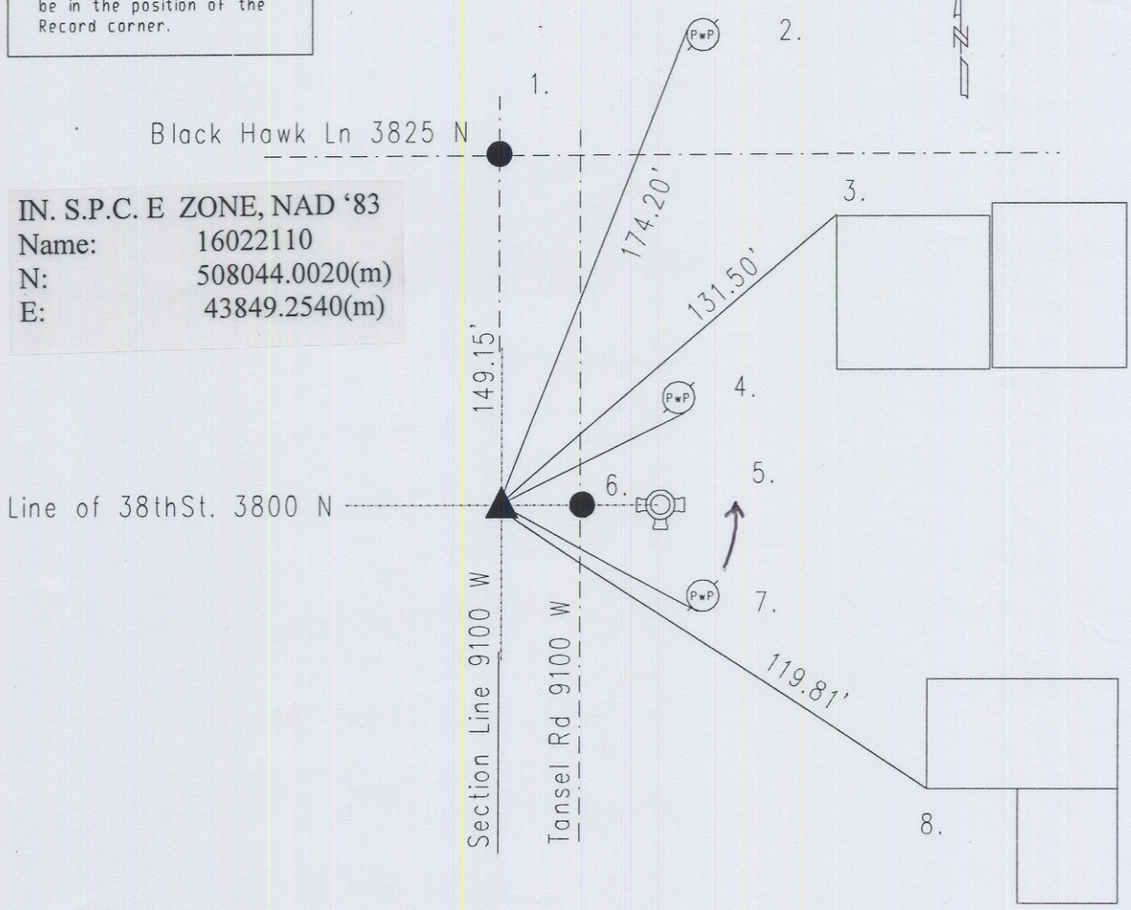

IN. S.P.C. E ZONE, NAD '83
Name: 16022110
N: 508044.0020(m)
E: 43849.2540(m)

SX622110

REF.	DISTANCE	DESCRIPTION
1.	149.15'	Due N to C/L of Black Hawk Lane : PK nail found
2.	174.20'	PK nail W PwP#29-388 B 40'up
3.	131.50'	NW corner of wooden garage ADDRESS 9047
4.	32.61'	Road nail SE PwP#141-388 B 12"up
5.	27.00'	Due E to top nut of fire hydrant
6.	10.00'	+/-Due E to C/L of pavement
7.	72.44'	PK nail S PwP#142-388 B 18"up
8.	119.81'	SW corner brick ADDRESS 3769