OFFICE OF THE MARION COUNTY SURVEYOR
SECTION RECORD CORNER
SECTION 35 TOWNSHIP 16 RANGE 2
DATE: ~~5-25-99~~ 9-22-05
PARTY CHIEF: Wilcoxen
CREW:
TYPE OF MARKER: Harrison in grass median
METHOD OF ESTABLISHMENT: County: NEW:
Half-way on line

Note: Set Harrison on straight line between SW & SE corners. Traverse 35-16-2 completed in 1999 per DP.

IN. S.P.C. E ZONE, NAD 83
NAME: 16023508
N: 503205.2416(m)
E: 47543.9536(m)

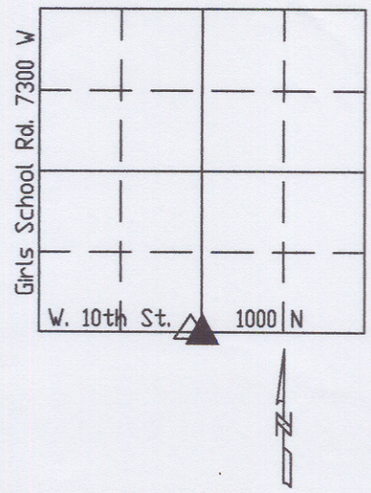

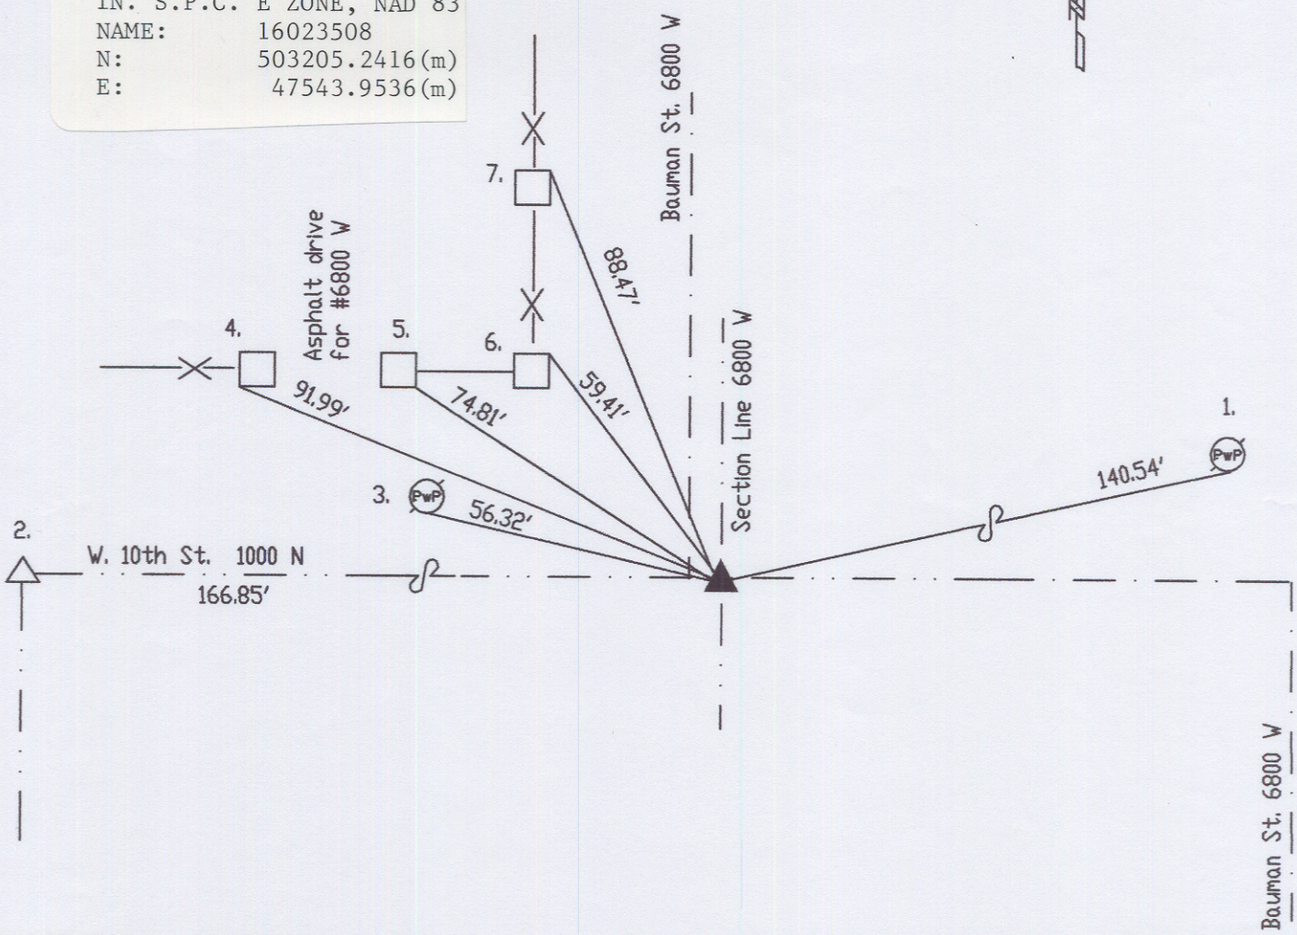

HX623508 HC623508

REF.	DISTANCE	DESCRIPTION
1.	140.54'	Mag nail w/brass washer S PwP#271-493A
2.	166.85'	Due W to N Q 2-15-2 (Brass plug in concrete)
3.	56.32'	Mag nail w/brass washer SW PwP#163-492A 10'up
4.	91.99'	SW fence post for address # 6800
5.	74.81'	SE fence post
6.	59.41'	NE corner fence post
7.	88.47'	NE fence post