OFFICE OF THE MARION COUNTY SURVEYOR
SECTION RECORD CORNER
SECTION 36 TOWNSHIP 16 RANGE 2
DATE: ~~6-5-2000~~ 7-26-06
PARTY CHIEF: Kiste
CREW:
TYPE OF MARKER: Survey marker nail set
METHOD OF ESTABLISHMENT: County: 10-2-89

IN. S.P.C. E ZONE, NAD 83
NAME: 16023603
N: 504872.9660(m)
E: 49965.6240(m)

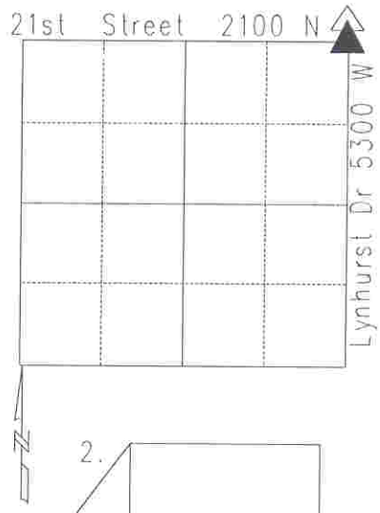

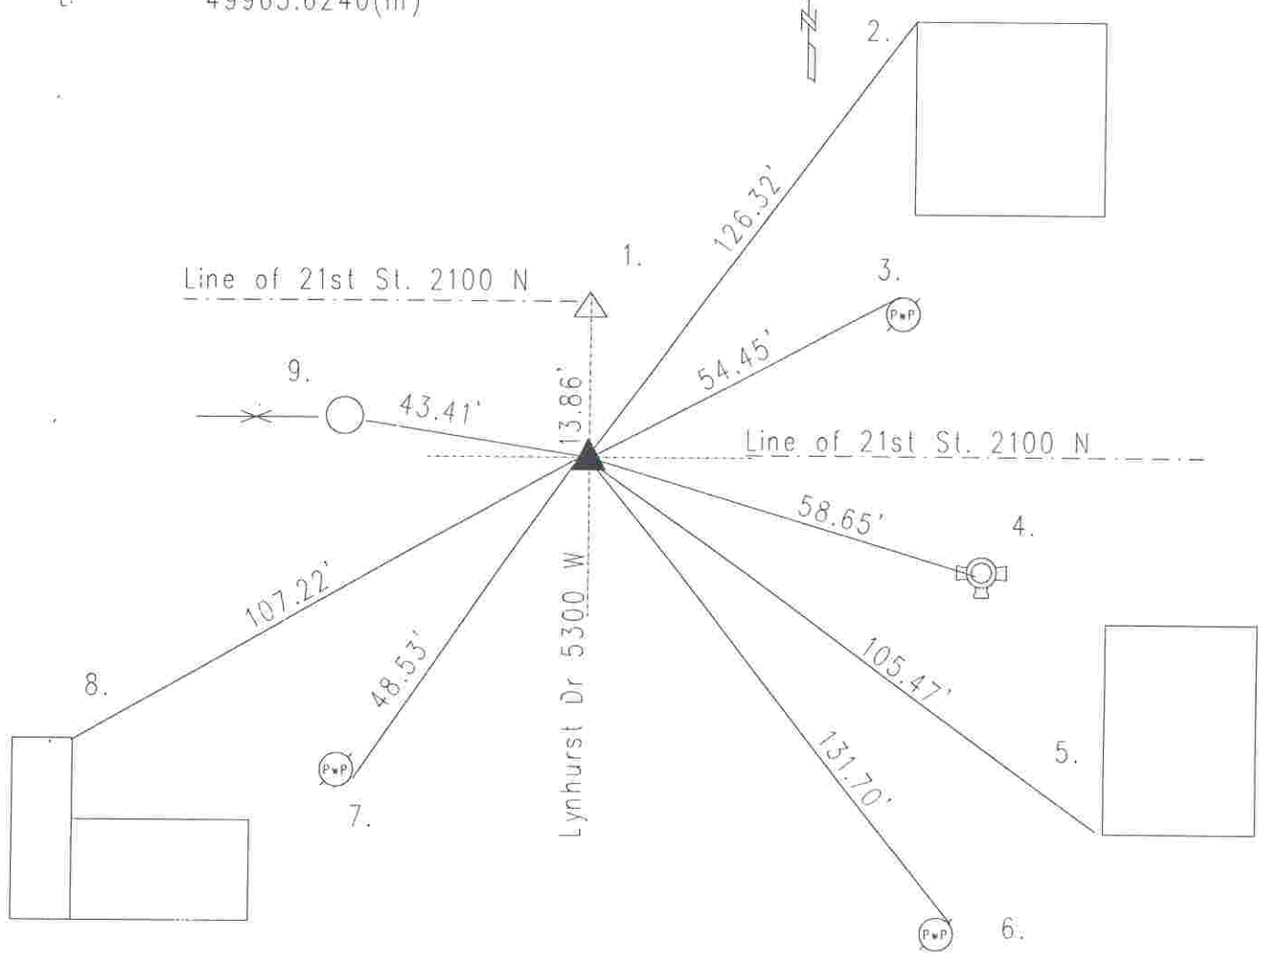

SC 623603

REF.	DISTANCE	DESCRIPTION
1.	13.86'	Due N to survey marker nail NW 31-16-3
3.	54.45'	PK nail NW PwP#1-456A 4"up
4.	58.65'	Top nut of fire hydrant
5.	105.47'	SW corner of brick ADDRESS 2055
6.	131.70'	PK nail E PwP#175-456B 4"up
7.	48.53'	PK nail SE PwP#221-455B 2"up
8.	107.22'	NE corner of ADDRESS 2050 wood
9.	43.41'	Face of steel chain link fence post