OFFICE OF THE MARION COUNTY SURVEYOR
SECTION RECORD CORNER
SECTION 6 TOWNSHIP 16 RANGE 3
DATE: 10-31-05
PARTY CHIEF: Wilcoxen
CREW:
TYPE OF MARKER: Survey mark nail set
METHOD OF ESTABLISHMENT: County: 7-17-00

NOTE: This corner position represents a title corner and may not necessarily be in the position of the Record corner.

In. S.P.C. E ZONE, NAD '83
Name: 16030611
N: 512952.6040(m)
E: 50853.8540(m)

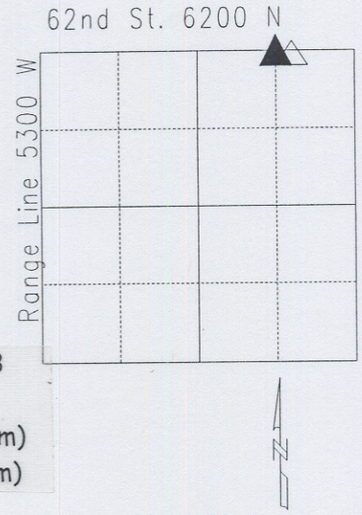

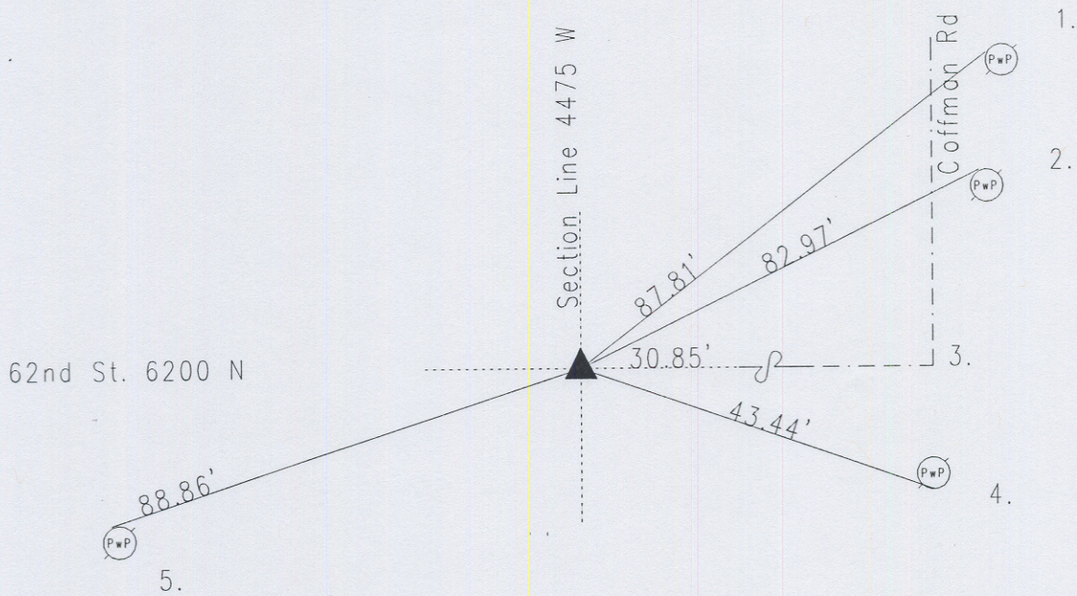

16030611

REF.	DISTANCE	DESCRIPTION
1.	87.81'	PK nail W PwP#1-297A 6"up
2.	82.97'	PK nail NW PwP#263-297A 5"up
3.	30.85'	Due E to SE corner of 36-17-2 :Harrison
4.	43.44'	Mag nail w/brass washer S PwP#73-297 B 12"up
5.	88.86'	Mag nail w/brass washer N PwP#5-297B 15"up