OFFICE OF THE MARION COUNTY SURVEYOR
SECTION RECORD CORNER
SECTION 8 TOWNSHIP 16 RANGE 3
DATE: 8-8-96
PARTY CHIEF: Kiste
CREW:
TYPE OF MARKER: PK nail
METHOD OF ESTABLISHMENT: County: 6-11-86

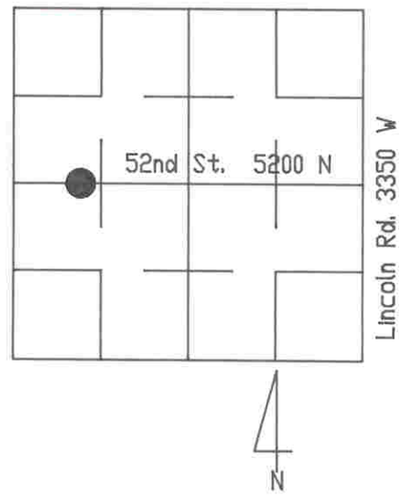

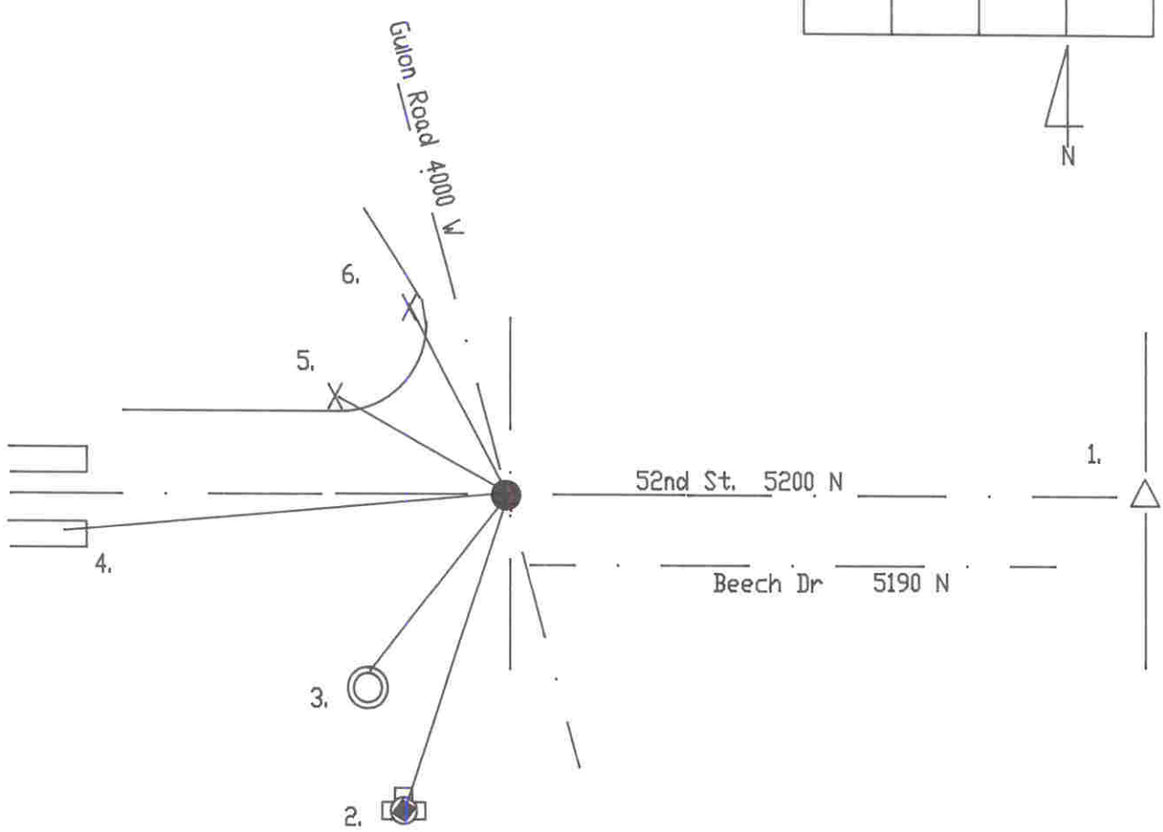

PX6308A

REF.	DISTANCE	DESCRIPTION
1.	189.70'	Due E to 'sq. cut stone' SE, SW, NW Sec. 8
2.	93.54'	Top nut
3.	51.65'	'x' N-side manhole rim
4.	191.84'	'x' E-end of south-bridge walk
5.	49.50'	PK mortar joint in wall 12"up
6.	48.46'	PK mortar joint in wall 12"up