OFFICE OF THE MARION COUNTY SURVEYOR
SECTION RECORD CORNER
SECTION 18 TOWNSHIP 16 RANGE 3
DATE: 11-29-07
PARTY CHIEF: Wilcoxen
CREW:
TYPE OF MARKER: Harrison set
METHOD OF ESTABLISHMENT: County: 5-10-01

IN. S.P.C. E ZONE NAD '83
NAME: 16031802
N: 509754.6767(m)
E: 50496.8492(m)

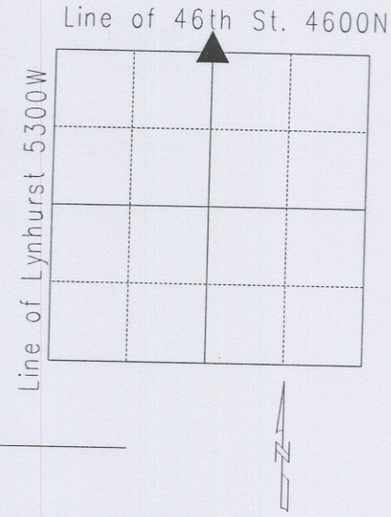

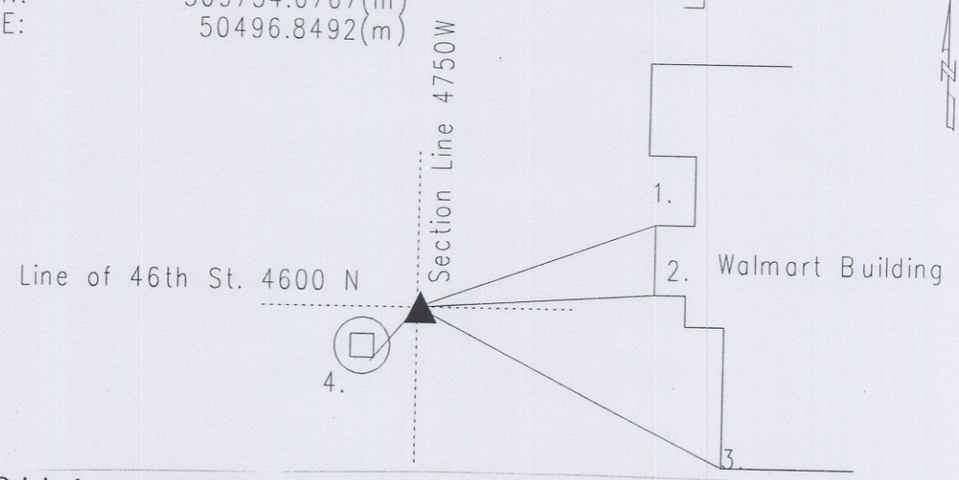

Original post set 1820 by Laughlin with witness: 24" sugar S 48 E 24 links; 14" sugar N 39 E 21 links. Post set 40 chains W of the NE corner of Sec. 18 and 28.25 chains E of the NW of said section. Legal survey per Pike Township Legal Survey Book pg. 12 per Fatout 12-8-1879 does not identify corner by letter or symbol but; shows distance of 28.34 chains to the NW of the Section. Pike Township legal Survey Book pg. 31 per Hosbrook 10 & 11-1850 called corner #14 describes it as "set rock both stumps". Distance of 28.50 chains and 40.28 chains shown to the NW and NE corners of said Section. Pike Township legal Survey Book pg. 68 per Seward & Walton, May, 1950 called stone NW of section, cross in the centerline of Lafayette on section line, stone 195.20' E of said cross distance 1129.81' from stone E to NQ of said section. Based on Subsequent research, I believe the 1129.81' should be from cross...not the stone. Roxy & Gioscio 1950 called cross in Lafayette Road 195.2' E to NQ of said section. Monroe 1952 called date nail @ C/L of Lafayette Road 195.2' E to a stone. 12/1985 traversing completed to tie in available section corners and referenced points. Location of correct corner position was protracted between NE & NW corners of Sec. 18. Located on line from NW of 18 through POL in Lafayette Road 1950. Corner falls within 1' of deed. Re-tied 5-10-01 by Kiste. Re-tied 11-29-07 by Wilcoxen.

REF.	DISTANCE	DESCRIPTION
1.	42.47'	Corner of stone block
2.	40.12'	Corner of stone block
3.	48.50'	Corner of stone block
4.	4.65'	SE corner of metal light post base