OFFICE OF THE MARION COUNTY SURVEYOR
SECTION RECORD CORNER
SECTION 20 TOWNSHIP 16 RANGE 3
DATE: ~~7-18-2000~~ 11-13-07
PARTY CHIEF: Wilcoxen
CREW:
TYPE OF MARKER: Mag nail found
METHOD OF ESTABLISHMENT: County: 1-17-95

IN. S.P.C. E ZONE, NAD 83
NAME: 16032004
N: 507322.7400(m)
E: 51320.4350(m)

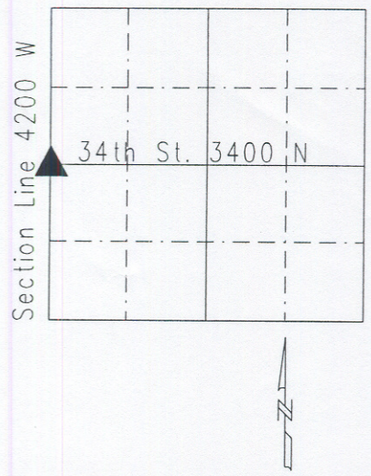

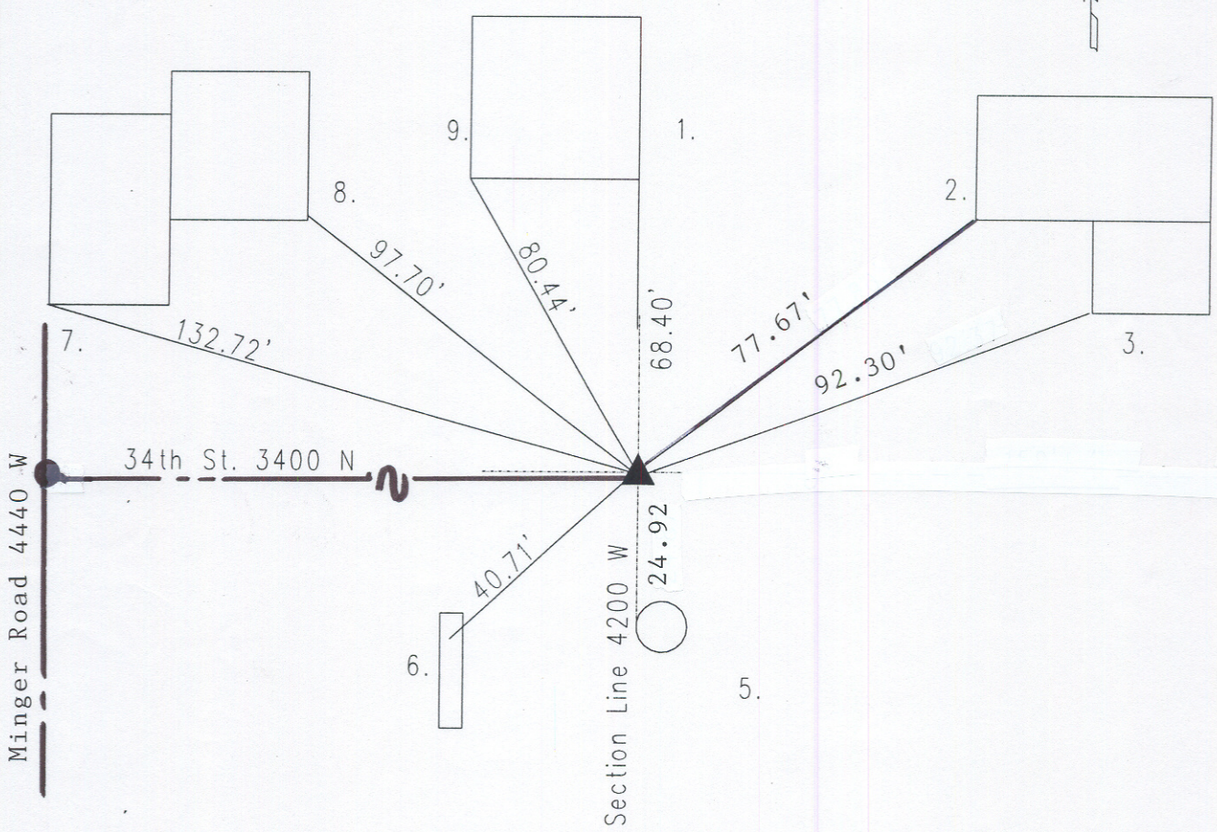

SC 632004

REF.	DISTANCE	DESCRIPTION
1.	68.40'	SE corner of foundation ADDRESS 4438
2.	77.67'	SW corner of stone ADDRESS 4424
3.	92.30'	SW corner "
4.	150'+/-	Due W to Minger Rd 4440 W
5.	24.92'	Mag nail w/brass washer W PwP#40-427A 14"up
6.	40.71'	Cut 'x' N-end of concrete headwall
7.	132.72'	SW corner foundation ADDRESS 4442
8.	97.70'	SE corner "
9.	80.44'	SW corner of ADDRESS 4438 foundation