OFFICE OF THE MARION COUNTY SURVEYOR
SECTION RECORD CORNER
SECTION 29 TOWNSHIP 16 RANGE 3
DATE: 8-29-06
PARTY CHIEF: Wilcoxen
CREW:
TYPE OF MARKER: Harrison
METHOD OF ESTABLISHMENT: County: 10-30-00

IN. S.P.C. E ZONE NAD '83
NAME: 16032902
N: 506523.0970(m)
E: 52138.1280(m)

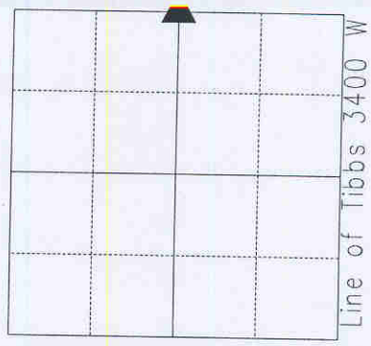

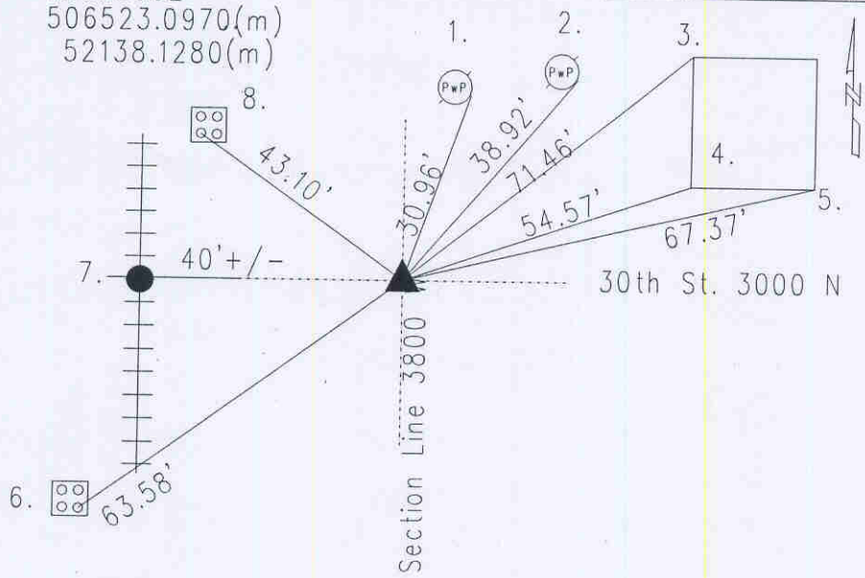

Original post set 1820 by Wm. B. Laughlin with witness: 14" beech N 25 W 14 links; 14" dogwood S 25 E 29 links per Marion County Atlas pg. 7. Hosbrook 8-17-1853 indicates no stone but witness: 22" beech N 8 E 7 linkns, per Wayne Township Legal Survey Book pg.38. Mayhew 4-16-1858 indicates a stone set agreeing with fences of long standing and on line between section corners per Wayne Township Legal Survey Book pg. 27. Monroe 6-27-52 called a railroad spike. Long 5-16-63 called a cross in concrete pavement. GWS 8-7-64 called a railroad spike set. Miller 12-23-75 called a railroad spike. Greene 6-27-86 called a railroad spike. Whiteside 9-10-96 called the same. Wilcoxen 2-21-99 called a railroad spike. Excavated by Wilcoxen 10-24-00, no stone or monu. fd.Harrison set. Re-tied 10-30-00 and again 8-29-06.

REF.	DISTANCE	DESCRIPTION
1.	30.96'	Mag nail w/bw F PwP#204-429 A 3"up
2.	38.92'	Mag nail w/bw SF PwP#1-429 A 20'up
3.	71.46'	Cut 'x' in bolt of legs of hightension tower
4.	54.47'	"
5.	67.37'	"
6.	78.71'	Mag nail w/bw NF PwP#448-429 B 20"up
7.	63.58'	Cut 'x' SF base of railroad crossing sign
8.	40.00'	Due W to Railroad track
9.	43.10'	Cut 'x' SW base of railroad crossing sign