OFFICE OF THE MARION COUNTY SURVEYOR
SECTION RECORD CORNER
SECTION 34 TOWNSHIP 16 RANGE 3
DATE: ~~7-18-2000~~ 9-1-06
PARTY CHIEF: Wilcoxen
CREW:
TYPE OF MARKER: Mag nail FD.
METHOD OF ESTABLISHMENT: County: 6-1-88

IN. S.P.C. E ZONE, NAD 83
NAME: 16033402
N: 504933.7232(m)
E: 55395.0425 (m)

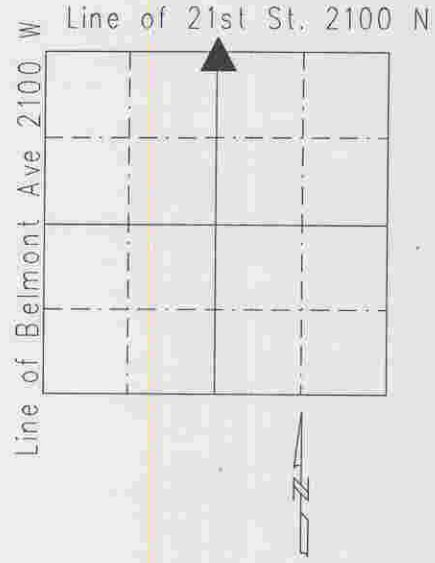

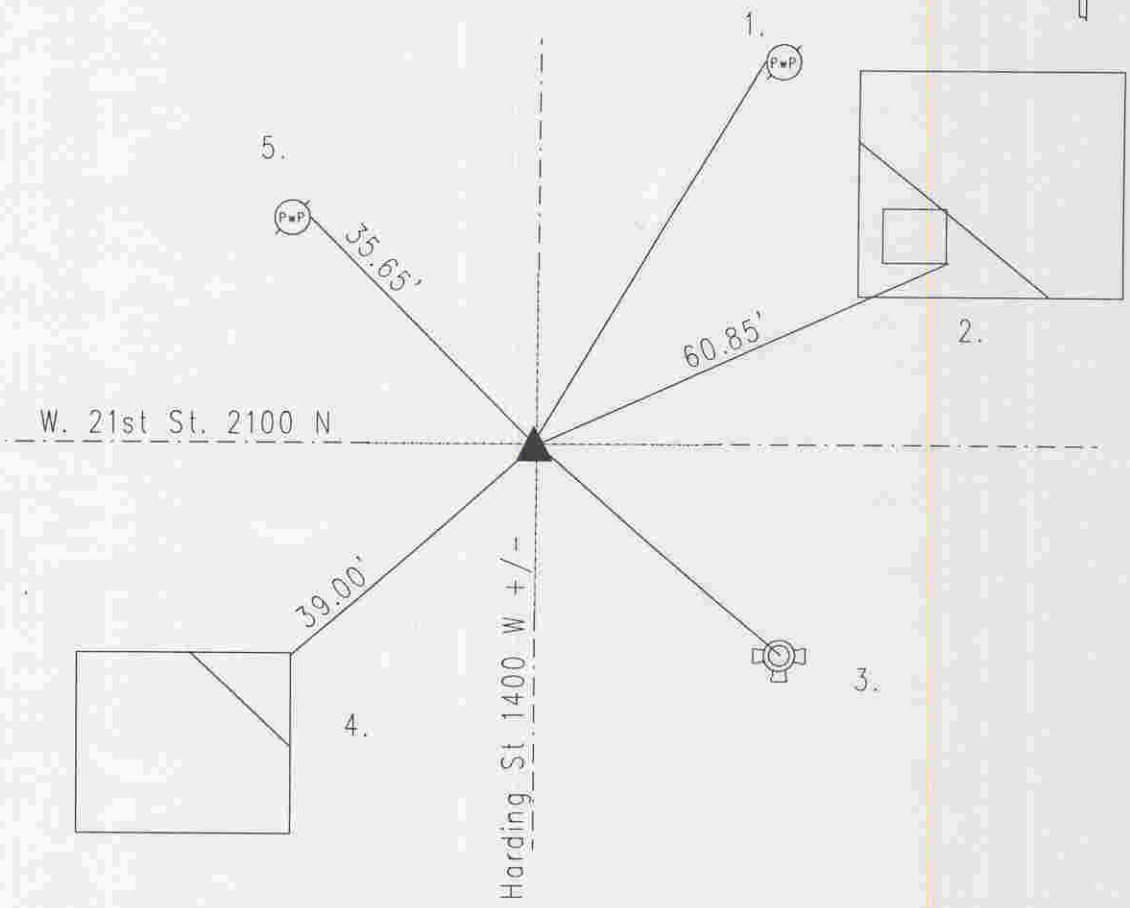

SC 633402

REF.	DISTANCE	DESCRIPTION
1.	49.88'	Mag nail w/brass washer W PwP#373-463A 10"up
2.	60.85'	SE corner of pillar
3.	43.40'	Top nut of fire hydrant
4.	39.00'	Corner of concrete step
5.	35.65'	Mag nail w/brass washer E PwP#19-462 A 10'up