OFFICE OF THE MARION COUNTY SURVEYOR
SECTION RECORD CORNER
SECTION 3 TOWNSHIP 16 RANGE 4
DATE: 1-25-05
PARTY CHIEF: Wilcoxen
CREW:
TYPE OF MARKER: Harrison
METHOD OF ESTABLISHMENT: County: 5-5-01

IN. S.P.C. E ZONE NAD '83
NAME: 16040301
N: 513019.7625(m)
E: 64286.3577(m)

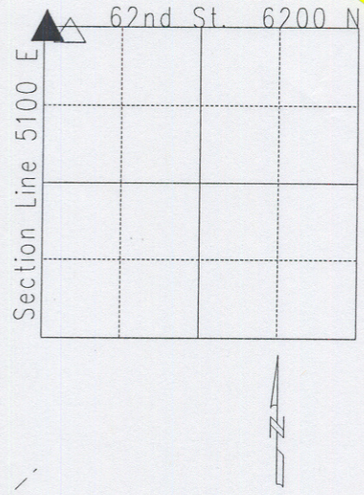

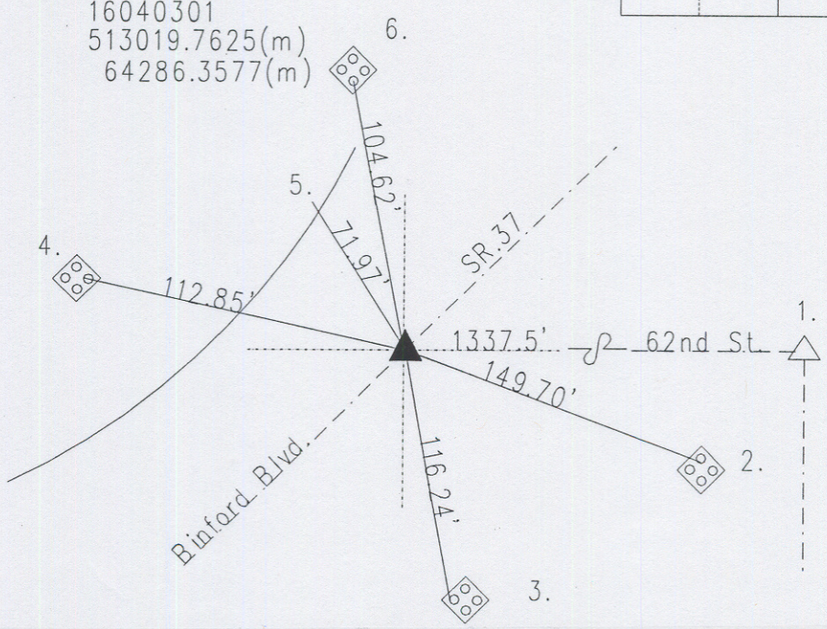

Corner originally set as a post in 1820 by John Hendricks with the following witnesses: 32" Hickory bearing north 52 degrees, thence west 31 links; and a 18" dogwood bearing south 45 degrees, thence east 48 links. (M.C. Atlas p. 11) Corner referenced by Monroe in May 1956 and called a cut x in pavement. Corner referenced by MCS in 1962 and called a brass plug. Corner referenced by McLand on 10/8/71 and called a brass plug. Corner referenced by Fortner on 12/20/74 and called a p.k. nail. Corner referenced by Greene on 1/21/88 and called a p.k. nail. Corner excavated by Wilcoxen on 2/22/96 and no stone or brass plug was found. A r.r. spike was set. Corner referenced by Whiteside on 5/5/01 and called a r.r. spike. Corner excavated by Kiste on 12/6/04 and a #205 cast iron Harrison Monument was set as per ties.

16040301

REF.	DISTANCE	DESCRIPTION
1.	1337.5'	Due E to S Q 33-17-4
2.	149.70'	Cut 'x' N-bolt of aluminum pole base
3.	116.24'	Cut 'x' E bolt of aluminum pole base
4.	112.85'	Cut 'x' E-bolt of aluminum pole base
5.	71.97'	Cut 'x' N-end of curb
6.	104.62'	Cut 'x' S-bolt of aluminum pole base