OFFICE OF THE MARIÓN COUNTY SURVEYOR
SECTION RECORD CORNER
SECTION 16 TOWNSHIP 16 RANGE 4
DATE: 11-7-07
PARTY CHIEF: Wilcoxen
CREW:
TYPE OF MARKER: Harrison w/sec. cap
METHOD OF ESTABLISHMENT: County: 11-5-99

IN. S.P.C. E ZONE NAD '83
NAME: 16041604
N: 509053.9770(m)
E: 62669.4720(m)

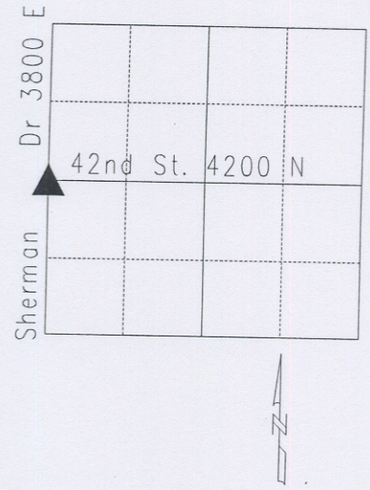

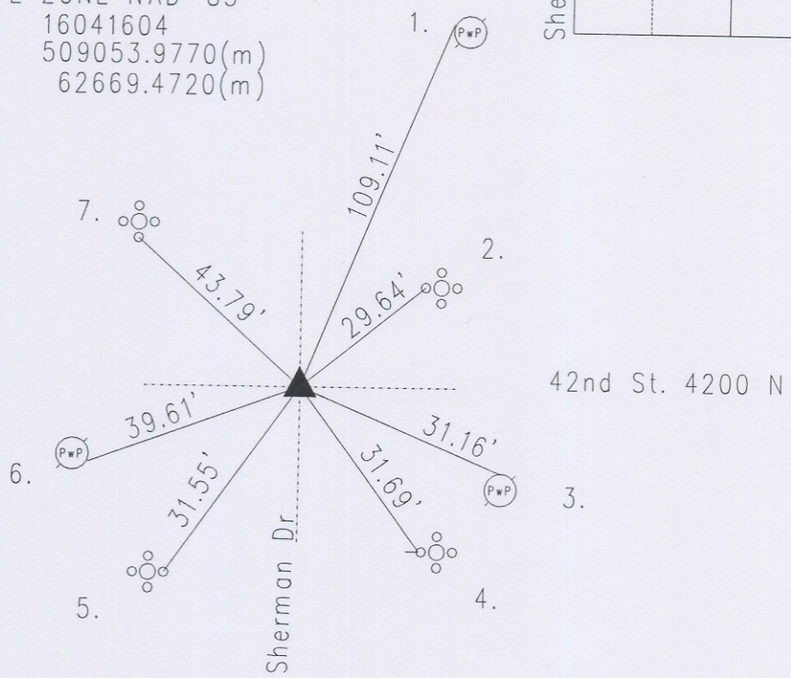

Original post set 1820 by John Hendricks with witness: 18" beech S 49 W 29 links; 15" dogwood N 47 W 32 links per Marion County Atlas pg. 11. A survey by D.B. Hosbrook 3-6-1854 indicates a found rock with witness: 30" oak S 47 W 45 links per Washington Township Legal Survey Book pg. 26. Miller 9-27-48 called a lead plug. Fleener 8-30-68 called an iron pin found 6 1/4" below asphalt on top of old concrete. McLand 6-28-73 called a PK nail. Wilcoxen 12-18-75 called a PK nail. Kiste 10-27-94 called PK nail w/washer set. Kiste 7-8-99 called same. Excavated by Wilcoxen 9-16-99 and a 1 1/2" pipe 18" long w/lead inside a pipe 6" down. No stone fd. Harrison Set. Re-tied 11-5-99 by Wilcoxen. Re-tied by Wilcoxen 11-7-07. 16041604

REF.	DISTANCE	DESCRIPTION
1.	109.11'	Mag nail w/bw W PwP#1-372
2.	29.64'	Cut 'x' W-bolt of street light pole base
3.	31.16'	Mag nail w/bw NE PwP#23-412A 5"up
4.	31.69'	Cut 'x' W-bolt of street light pole base
5.	31.55'	Cut 'x' E-bolt of street light pole base
6.	39.61'	Mag nail w/bw SE PwP#514-411A 6"up
7.	43.79'	Cut 'x' S bolt of street light pole base