OFFICE OF THE MARION COUNTY SURVEYOR
SECTION RECORD CORNER
SECTION 17 TOWNSHIP 16 RANGE 4
DATE: 9-25-02
PARTY CHIEF: Wilcoxen
CREW:
TYPE OF MARKER: Note:
METHOD OF ESTABLISHMENT: County:

IN. S.P.C. E ZONE NAD '83
NAME: PX6417B
N: 508861.3656(m)
E: 61445.7867(m)

NOTE: This corner position represents a title corner and may not necessarily be in the position of the Record corner.

NOTE: Survey marker nail over 1 1/2" steel pin 5" down per Cripe survey.

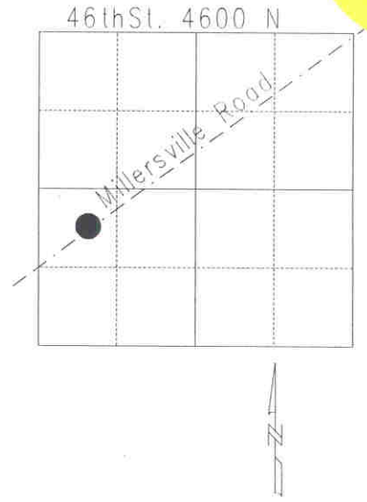

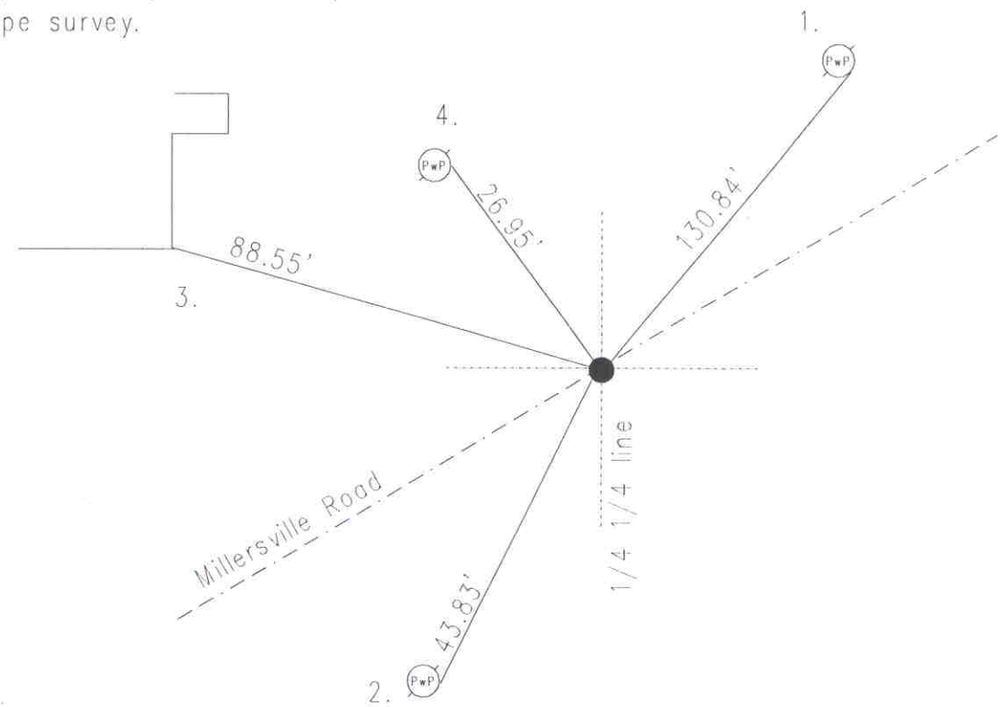

PX6417 B

REF.	DISTANCE	DESCRIPTION
1.	130.84'	PK nail E PwP# no # 4"up
2.	43.83'	Mag nail w/brass washer E PwP#60-401 A
3.	88.55'	SE corner of church building
4.	26.95'	Mag nail w/brass washer E PwP#118-410 A 4"up