OFFICE OF THE MARION COUNTY SURVEYOR

SECTION RECORD CORNER

SECTION 24 TOWNSHIP 16 RANGE 4

DATE: ~~5-21-2000~~ 10-24-06

PARTY CHIEF: Wilcoxen

CREW:

TYPE OF MARKER: PK nail FD

METHOD OF ESTABLISHMENT: County: 3-16-95

IN. S.P.C. E ZONE, NAD 83

NAME: 16042401

N: 508239.1400(m)

E: 67539.3790(m)

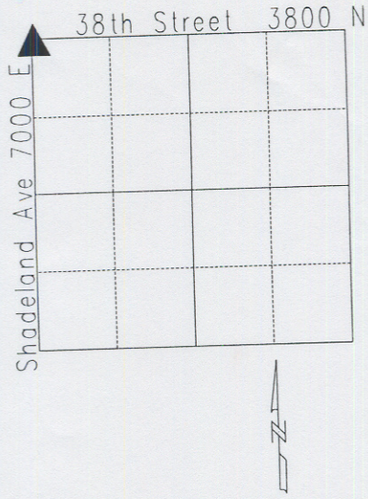


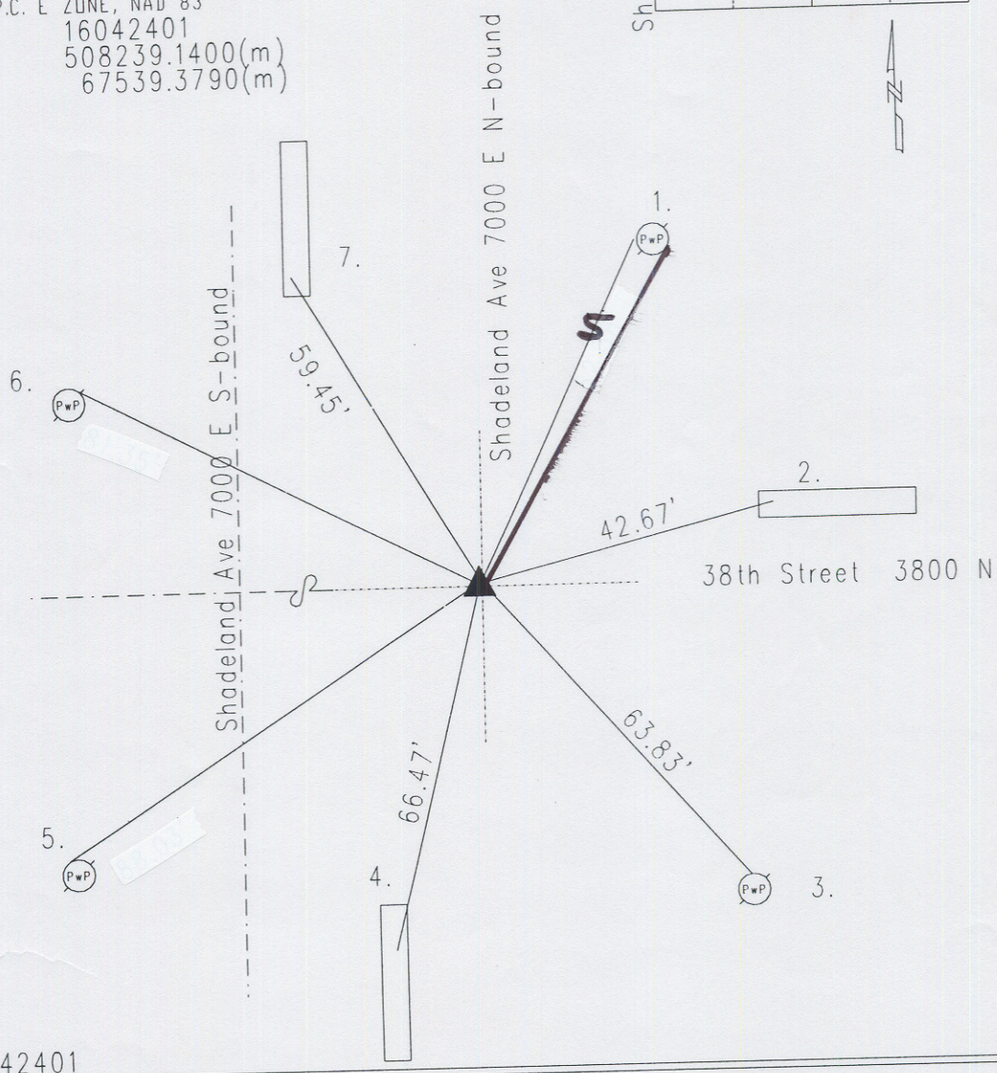


SC 642401

| REF. | DISTANCE | DESCRIPTION |
|---|---|---|
| 1. | 62.28' | Mag nail w/bw SE PwP#29-418B 12"up |
| 2. | 42.67' | Cut 'x' W-end of median |
| 3. | 63.83' | PK nail NE PwP#288-418A 12"up |
| 4. | 66.47' | Cut 'x' N-end of median |
| 5. | 88.08' | PK nail NW PwP#131-417B 12"up |
| 6. | 81.42' | PK nail NE PwP#45-417A 12"up |
| 7. | 59.45' | Cut 'x' S-end of median |