OFFICE OF THE MARION COUNTY SURVEYOR
SECTION RECORD CORNER
SECTION 25 TOWNSHIP 16 RANGE 4
DATE: 6-27-04
PARTY CHIEF: Wilcoxen
CREW:
TYPE OF MARKER: PK nail found
METHOD OF ESTABLISHMENT: County: 2-13-97

IN. S.P.C. E ZONE NAD '83
NAME: 16042503
N: 506605.9180(m)
E: 69167.3950(m)

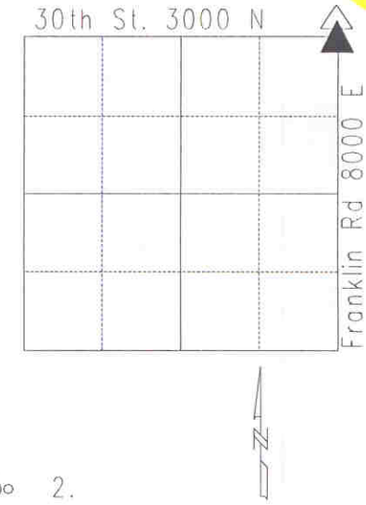

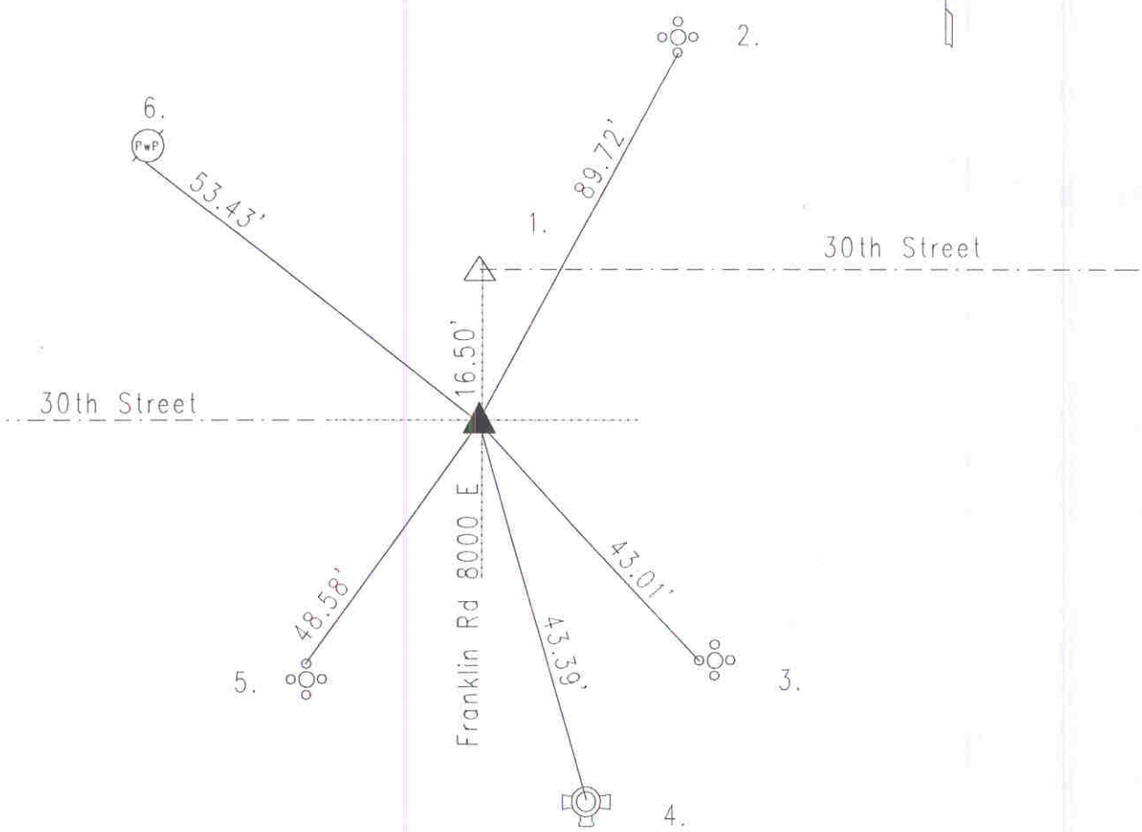

16042503

REF.	DISTANCE	DESCRIPTION
1.	16.50'	Due N to NW 30-16-5 PK nail found
2.	89.72'	Cut 'x' S bolt of aluminum pole base
3.	43.01'	Cut 'x' W bolt of aluminum pole base
4.	43.39'	Top nut of fire hydrant
5.	48.58'	Cut 'x' N bolt of aluminum pole base
6.	53.43'	PK nail SW PwP#41-449 A 8"up