OFFICE OF THE MARION COUNTY SURVEYOR
SECTION RECORD CORNER
SECTION 27 TOWNSHIP 16 RANGE 4
DATE: 10-25-06
PARTY CHIEF: Wilcoxen
CREW:
TYPE OF MARKER: Brass plug Fd Note:
METHOD OF ESTABLISHMENT: County: 8-9-00
Note: on median 1.15' E of W edge of median
IN. S.P.C. E ZONE NAD '83
NAME: 16042704
N: 505793.7673(m)
E: 64313.4483(m)

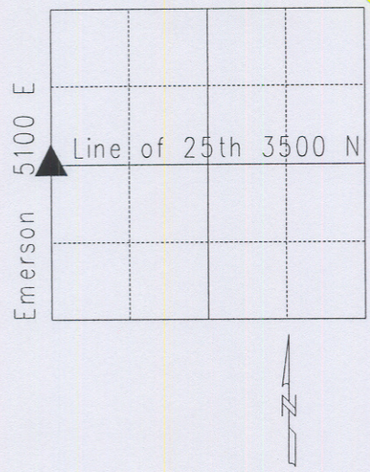

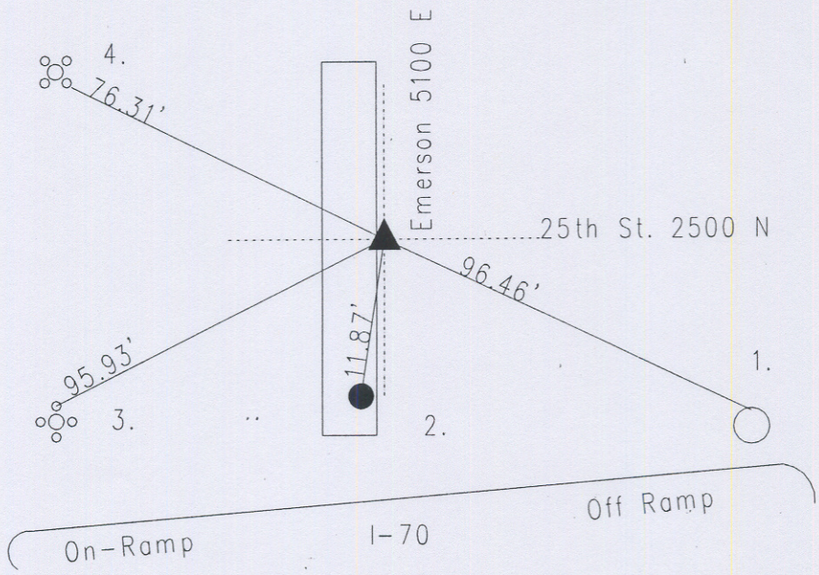

Original post set 1820 by Hendricks with witness: 20" beech N 40 W 13 links; 18" dogoowd S 22 E 27 links per Marion County Atlas pg. 11. Hosbrook 4-7-1852 called no stone but witness: 14" beech N 69 W 47 links & 10" sugar N 24 E 108 links per Warren Township Legal Survey Book pg. 6. Miller 9-25-48 called sq. head iron pin. Monroe 5-17-61 called same. MCSO 8-22-62 called same. McLand 2-24-71 called PK nail. Wilcoxen 12-9-76 called cut 'x' in median. Gries 12-4-87 called same. Kiste 9-27-95 called copperweld set w/cut 'x'. Re-set by Wilcoxen 5-26-00 per GPS. Cut 'x' in median per construction of new road. Re-tied by Wilcoxen 8-9-00 brass plug set. Re-tied 10-25-06 by Wilcoxen.

16042704

REF.	DISTANCE	DESCRIPTION
1.	96.46'	Cut 'x' N side of aluminum pole 18"up
2.	11.87'	Mag nail w/bw median concrete joint
3.	95.93'	Cut 'x' N bolt of aluminum pole
4.	76.31'	Cut 'x' SE bolt of I-70 West highway sign