OFFICE OF THE MARION COUNTY SURVEYOR
SECTION RECORD CORNER
SECTION 28 TOWNSHIP 16 RANGE 4
DATE: 11-29-07
PARTY CHIEF: Wilcoxen
CREW:
TYPE OF MARKER: Fd cut 'x' in concrete 4" dn
METHOD OF ESTABLISHMENT: County: & painted
8-23-97
IN. S.P.C. E ZONE NAD '83
NAME: 16042821
N: 505381.1132(m)
E: 63498.2876(m)

NOTE: This corner position represents a title corner and may not necessarily be in the position of the Record corner.

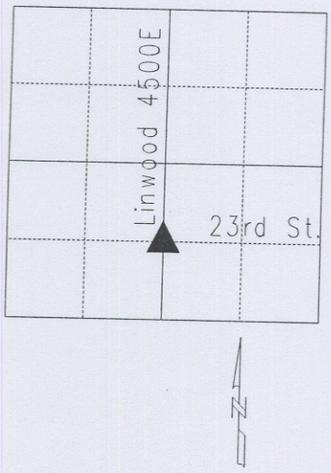

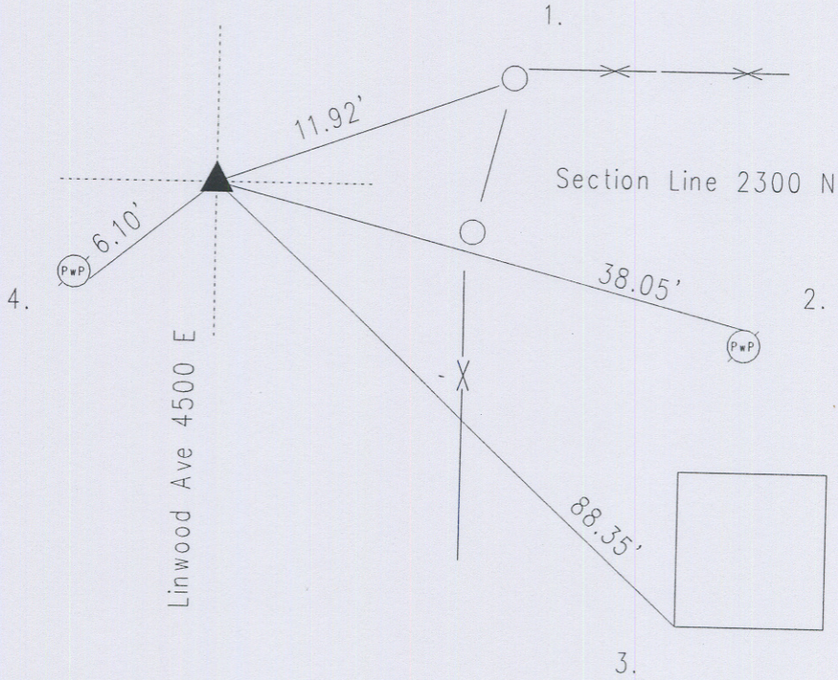

16042821

REF.	DISTANCE	DESCRIPTION
1.	11.92'	Face of steel corner fence post chain link fence
2.	38.05'	Road nail N PwP#255-473 A 10"up
3.	88.35'	SW corner of ADDRESS 2233 siding
4.	6.10'	Mag nail SF PwP no# 12"up