OFFICE OF THE MARION COUNTY SURVEYOR
SECTION RECORD CORNER
SECTION 15 TOWNSHIP 16 RANGE 5
DATE: 1-19-05
PARTY CHIEF: Wilcoxen
CREW:
TYPE OF MARKER: Harrison
METHOD OF ESTABLISHMENT: County: 5-8-00

IN. S.P.C. E ZONE NAD '83
NAME: 16051502
N: 509937.6570(m)
E: 74642.0600(m)

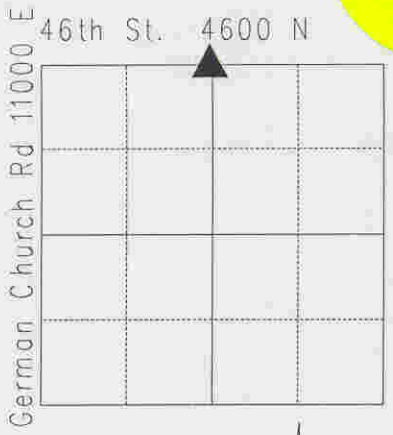

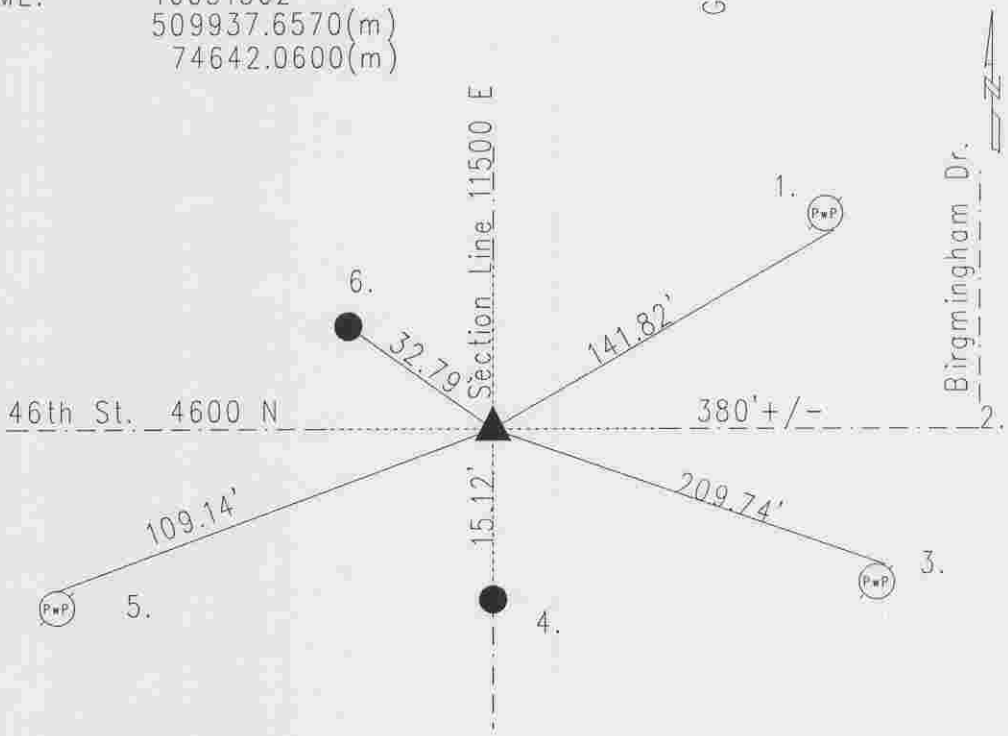

Original post set 1866 by Smith, stone set with witness: 12" walnut S 12 E 33 links, 15" beech N 48 W 39 links per Marion County Atlas pg. 15. 11-10-51 Monroe called stone. 3-25-58 called 1/2" iron pipe over stone. 3-25-70 SeFranka called the same. 5-26-72 SeFranka called same. 11-16-76 Miller called same. 5-10-90 Wilcoxen excavated and found 1/2" iron pipe 4" down. Stone found 11" down. iron pipe was .13' N and .23' E of stone. Harrison set. Re-tied 5-10-90 by Wilcoxen. Re-tied 10-4-94 by Kiste. Re-tied 5-8-00 by Wilcoxen. Re-tied 1-19-05 by Wilcoxen.

16051502

REF.	DISTANCE	DESCRIPTION
1.	141.82'	Mag nail w/brass washer SF PwP#224-381F 15"up
2.	380'+/-	Due E to C/L Birmingham Drive
3.	209.74'	Mag nail w/brass washer N PwP#25-381F 15"up
4.	15.12'	Due S to railroad spike found
5.	109.14'	PK nail N PwP#42-381F
6.	32.79'	Railroad spike found