OFFICE OF THE MARION COUNTY SURVEYOR
SECTION RECORD CORNER
SECTION 17 TOWNSHIP 16 RANGE 5
DATE: ~~8-12-01~~ 3-06-06
PARTY CHIEF: Wilcoxen
CREW:
TYPE OF MARKER: Harrison
METHOD OF ESTABLISHMENT: County: 7-23-01

IN. S.P.C. E ZONE NAD '83
NAME: 16051702
N: 509897.8050(m)
E: 71408.4060(m)

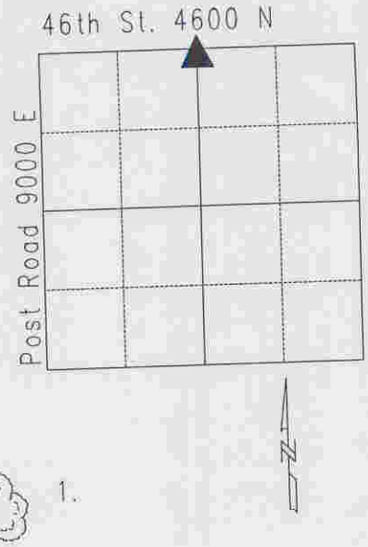

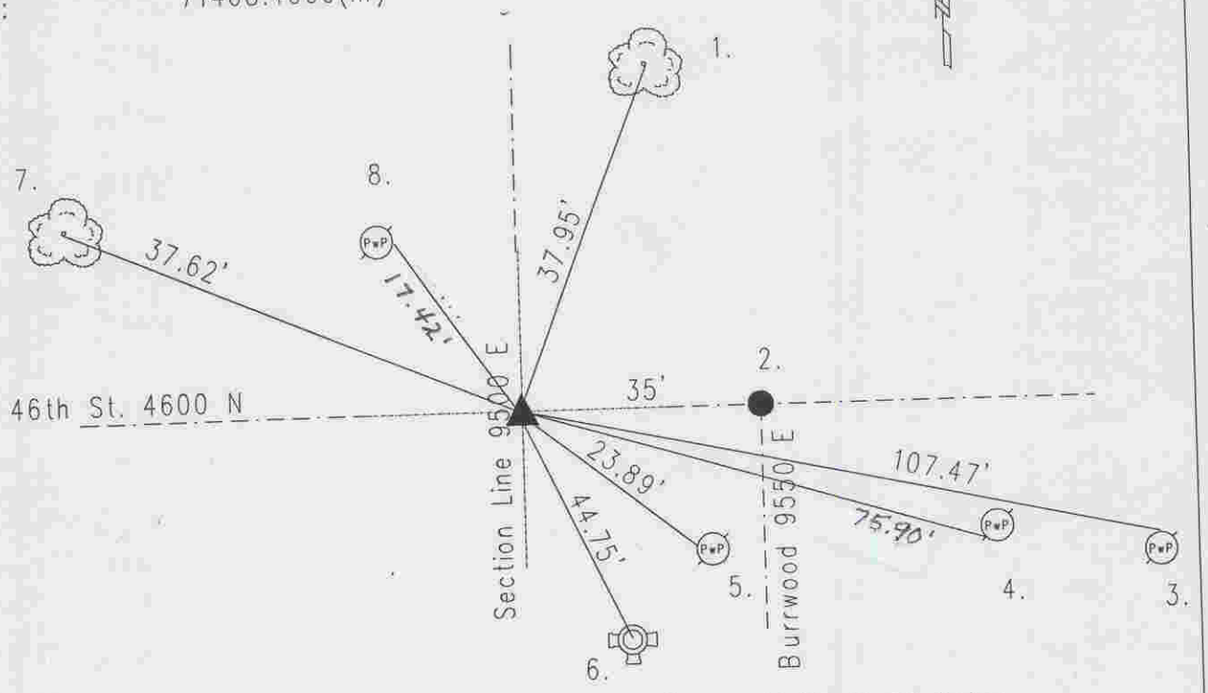

Original post set 1820 by Hendricks with witnesses: 38" ash N 57 W 33 links; 11" beech S 81 W 29 links per Marion County Atlas pg. 15. Stone set per Voorhis 1871. 7-5-56 Monroe called stone. 11-5-70 McLand called stone fd. 6" down. 3-9-71 Fultz called railroad spike. 5-22-90 excavated and railroad spike found at surface. Stone found 6" down. Stone .20'W and .20'N of railroad spike. Harrison set. Re-tied 10-3-96 by Wilcoxen. Re-tied 7-23-01 by Wilcoxen.

16051702

REF.	DISTANCE	DESCRIPTION
1.	37.95'	Railroad spike SE 18" maple 12"up
2.	35' +/-	Due E to approximate C/L of Burrwood Dr. 9550 E
3.	107.47'	PK nail N PwP#20-381 BB 14"up
4.	75.90'	PK nail SW light pole #343-381 BB 8'up
5.	23.89'	PK nail W PwP#165-381 B 8"up
6.	44.75'	Top nut of fire hydrant
7.	37.62'	Boat spike SW 15" hickory 12"up
8.	17.42'	~~Road nail~~ E PwP#64-381 B ~~6"up~~ MAG NAIL 12" up