OFFICE OF THE MARION COUNTY SURVEYOR
SECTION RECORD CORNER
SECTION 28 TOWNSHIP 16 RANGE 5
DATE: ~~7-3-01~~ 3-01-06
PARTY CHIEF: Wilcoxen
CREW:
TYPE OF MARKER: Note:
METHOD OF ESTABLISHMENT: County: 10-17-96

IN. S.P.C. E ZONE, NAD 83
NAME: 16052802
N: 506659.7260(m)
E: 73056.9580(m)

NOTE: Boat spike w/washer set over copperweld 6" down.

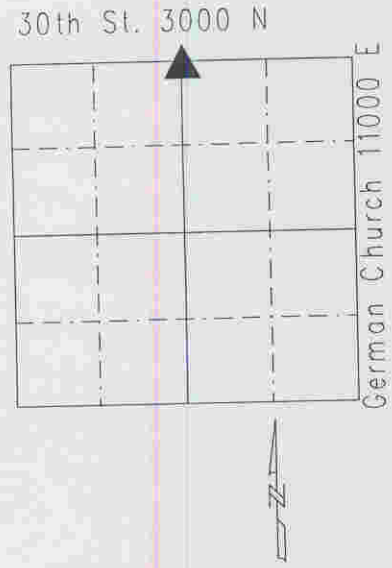

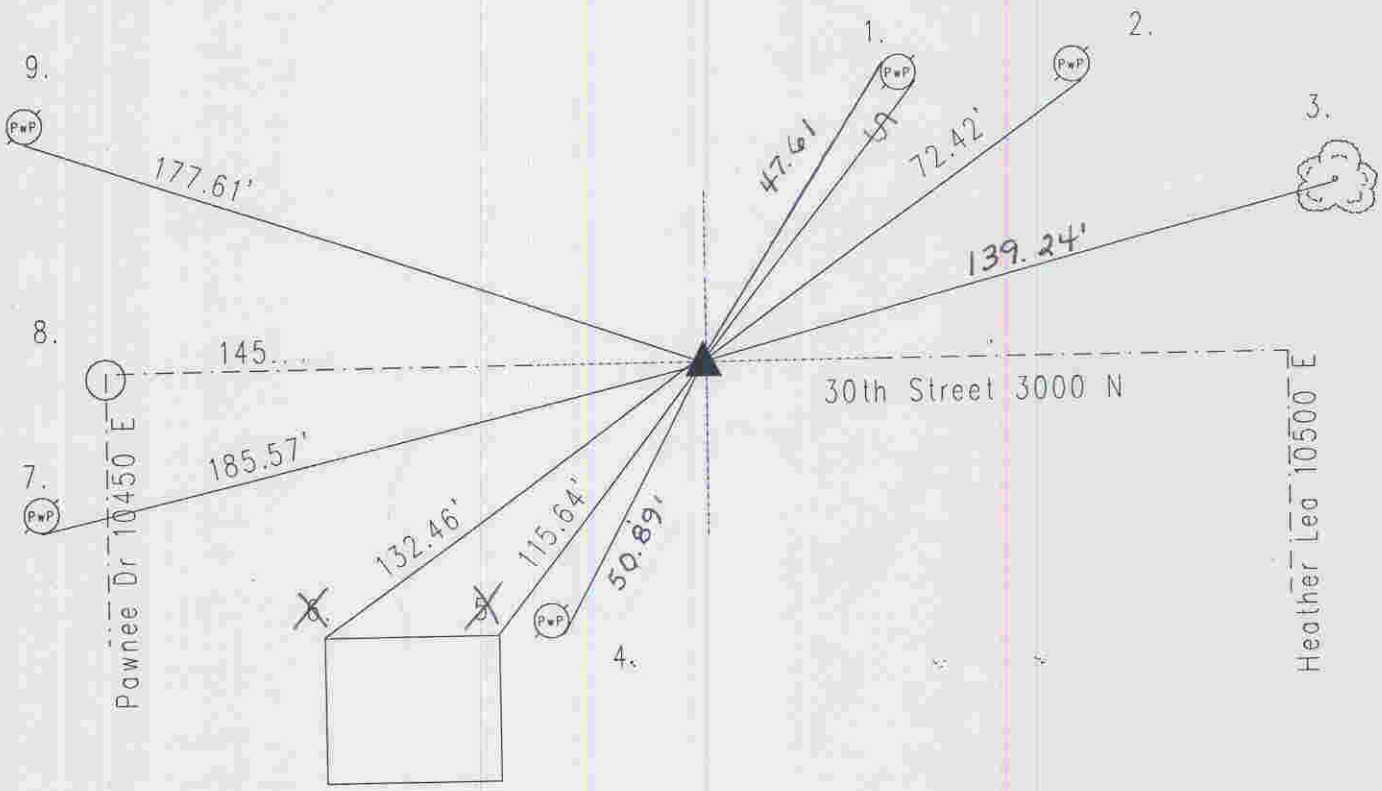

16052802

REF.	DISTANCE	DESCRIPTION
1.	47.61'	PK nail E pwP#318-451 C 20"up
2.	72.42'	PK nail SE PwP#84-841DA 12"up
3.	139.24'	Boat spike S spur root 20" maple
4.	50.89'	Road nail SE PwP#114-451CB 15"up
~~5.~~	~~115.64'~~	~~NE corner of frame at foundation~~ ADDRESS 2919
~~6.~~	~~132.46'~~	~~NW corner "~~
7.	185.57'	PK nail S PwP#113-451C 6"up
8.	145.+/-	Due W to C/L of Pawnee Drive 10450 E
9.	177.61'	PK nail S PwP#11-451CA 4"up