OFFICE OF THE MARION COUNTY SURVEYOR
SECTION RECORD CORNER
SECTION 32 TOWNSHIP 16 RANGE 5
DATE: ~~5-9-99~~ 6-30-04
PARTY CHIEF: Wilcoxen
CREW:
TYPE OF MARKER: Survey mark nail set
METHOD OF ESTABLISHMENT: County: 2-28-94

IN. S.P.C. E ZONE, NAD 83
NAME: 16053202
N: 505007.8250(m)
E: 71455.3040(m)

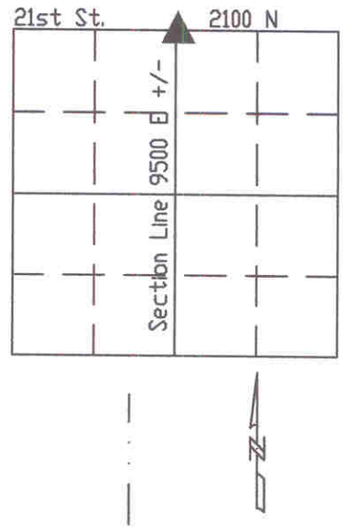

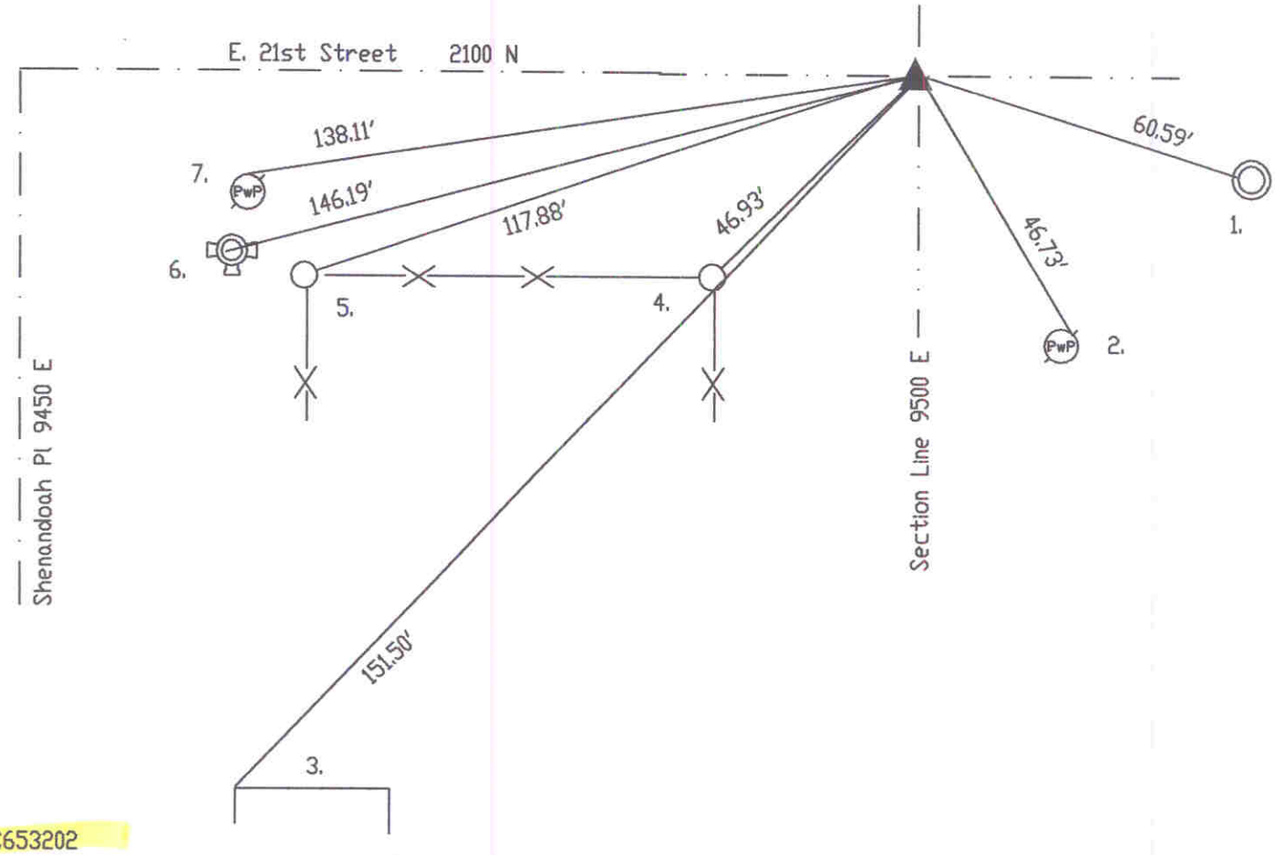

SC653202

REF.	DISTANCE	DESCRIPTION
1.	60.59'	Cut 'x' W-edge rim of manhole
2.	46.73'	Mag nail w/brass washer NE PwP#180-481AB 10"up
3.	151.50'	NW corner of brick building
4.	46.93'	Top center fence post
5.	117.88'	Top center fence post
6.	146.19'	Top nut of fire hydrant
7.	138.11'	Mag nail w/brass washer N PwP#218-81AB 10"up