OFFICE OF THE MARION COUNTY SURVEYOR
SECTION RECORD CORNER
SECTION 13 TOWNSHIP 17 RANGE 2
DATE: 4-5-02
PARTY CHIEF: Wilcoxen
CREW:
TYPE OF MARKER: Mag nail over broken off
METHOD OF ESTABLISHMENT: County: Harrison
4-4-97

IN. S.P.C. E ZONE NAD '83
NAME: 17021302
N: 519419.7060(m)
E: 50104.7570(m)

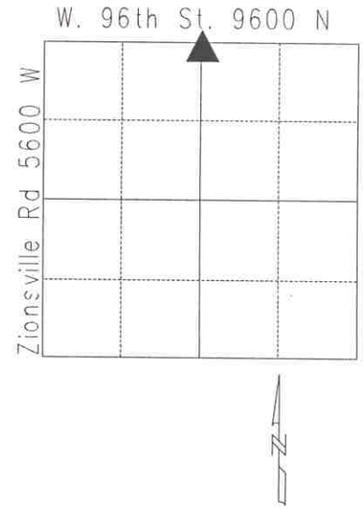

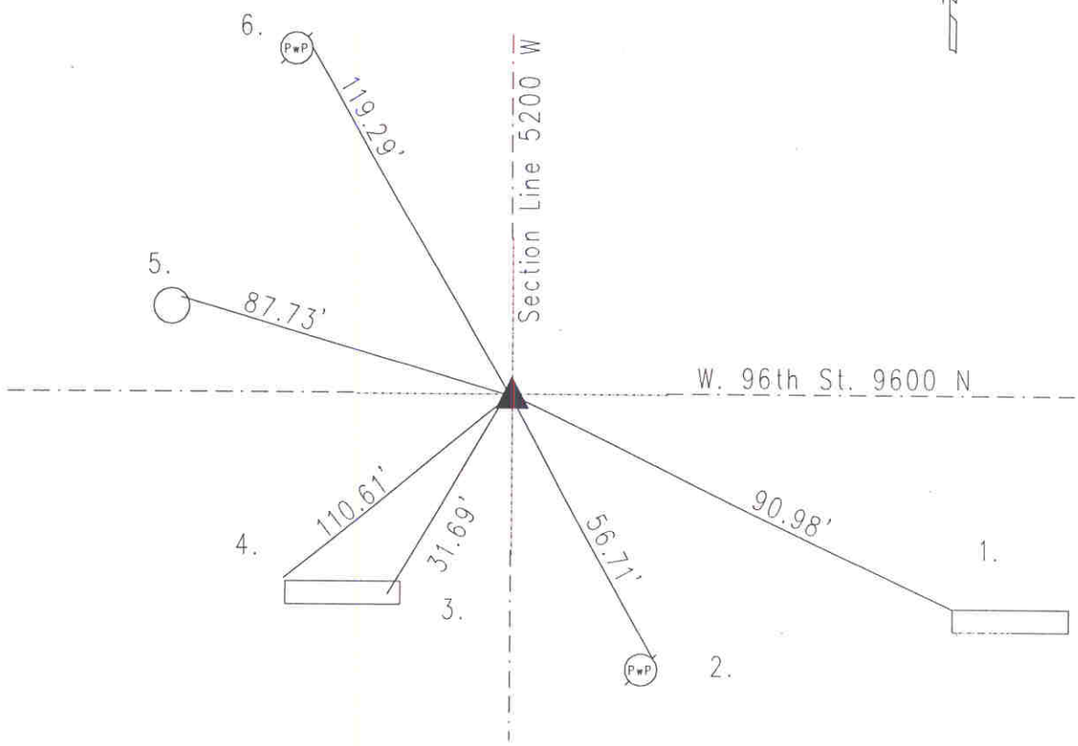

Original post set 1821 by Laughlin with witnesses: 12" ash S 50 22 links; 14" ash N 84 E 25 links per Marion County Atlas pg. 4. No reference to this corner in Pike Township Legal Survey Book . 10-10-69 called railroad spike 2" dn. Excavated 7-27-87 and a stone found 12" down. Harrison set.

Re-tied 4-4-97 by Wilcoxen. Re-tied 4-5-02 by Wilcoxen.
17021302

REF.	DISTANCE	DESCRIPTION
1.	90.98'	NW corner of concrete retaining wall
2.	56.71'	Mag nail w/ brass washer NE PwP no# 30"up
3.	31.69'	Cut 'x' E-end of concrete retaining wall
4.	110.61'	NW corner of concrete retaining wall
5.	87.73'	Cut 'x' NE corner of concrete bridge pillar 24"up
6.	119.29'	PK nail E PwP#187-122 24"up