OFFICE OF THE MARION COUNTY SURVEYOR
SECTION RECORD CORNER
SECTION 23 TOWNSHIP 17 RANGE 2
DATE: 4-11-02
PARTY CHIEF: Wilcoxen
CREW:
TYPE OF MARKER: Capped rebar over axle
METHOD OF ESTABLISHMENT: County: 4-7-97

IN. S.P.C. E ZONE NAD '83
NAME: 17022304
N: 516932.2970(m)
E: 47660.9470(m)

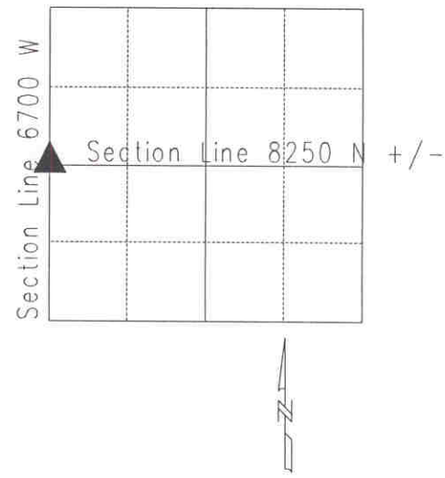

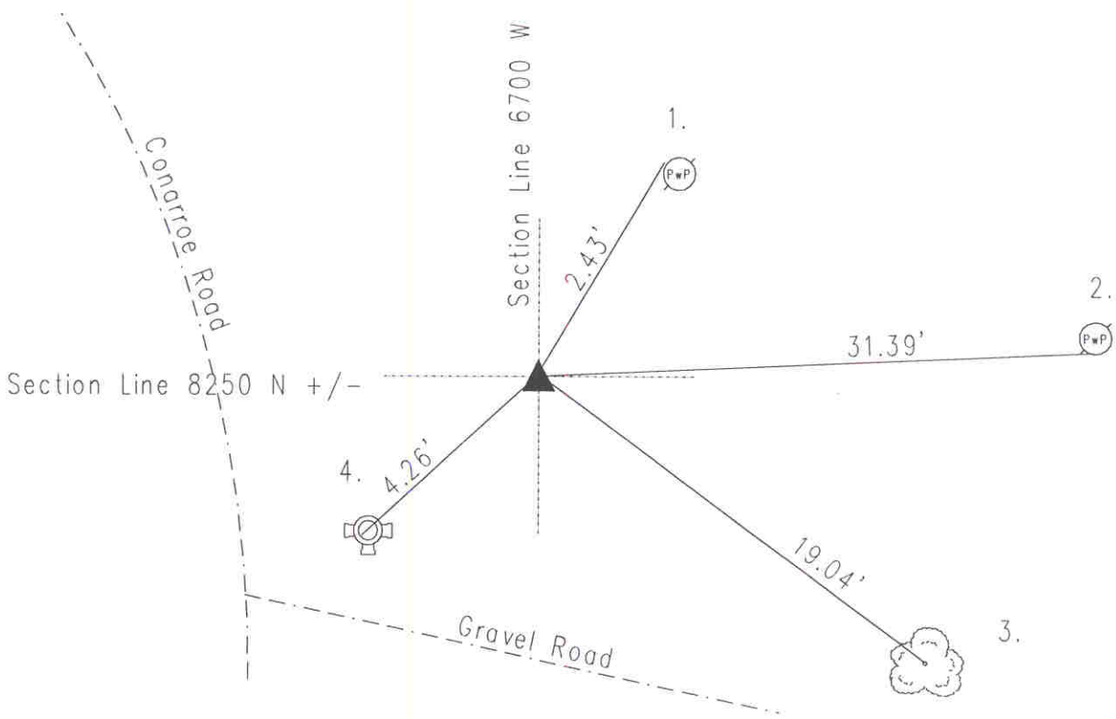

17022304

REF.	DISTANCE	DESCRIPTION
1.	2.43'	PK nail NW PwP#100-223 3"up
2.	31.39'	Mag nail w/brass washer S PwP#35E-223 12"up
3.	19.04'	Mag nail W twin hickory 15"up
4.	4.26'	Top nut of fire hydrant