The OFFICE of the MARION COUNTY SURVEYOR

SECTION CORNER RECORD
MARION COUNTY, INDIANA

Sec. 25 Twp. 17 Range 2

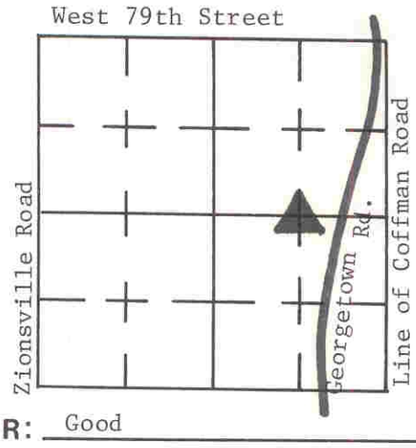

DATE: 5 - 7 - 75

CREW: P.C.- Miller

INST. - Hylden ROD. - Lauck

TYPE of MARKER: Iron Pin COND. of MARKER: Good

METHOD of ESTABLISHMENT: From County Ties

Recopied 11/27/81

This corner position represents a "Title" corner and may not necessarily be in the position of the record corner.

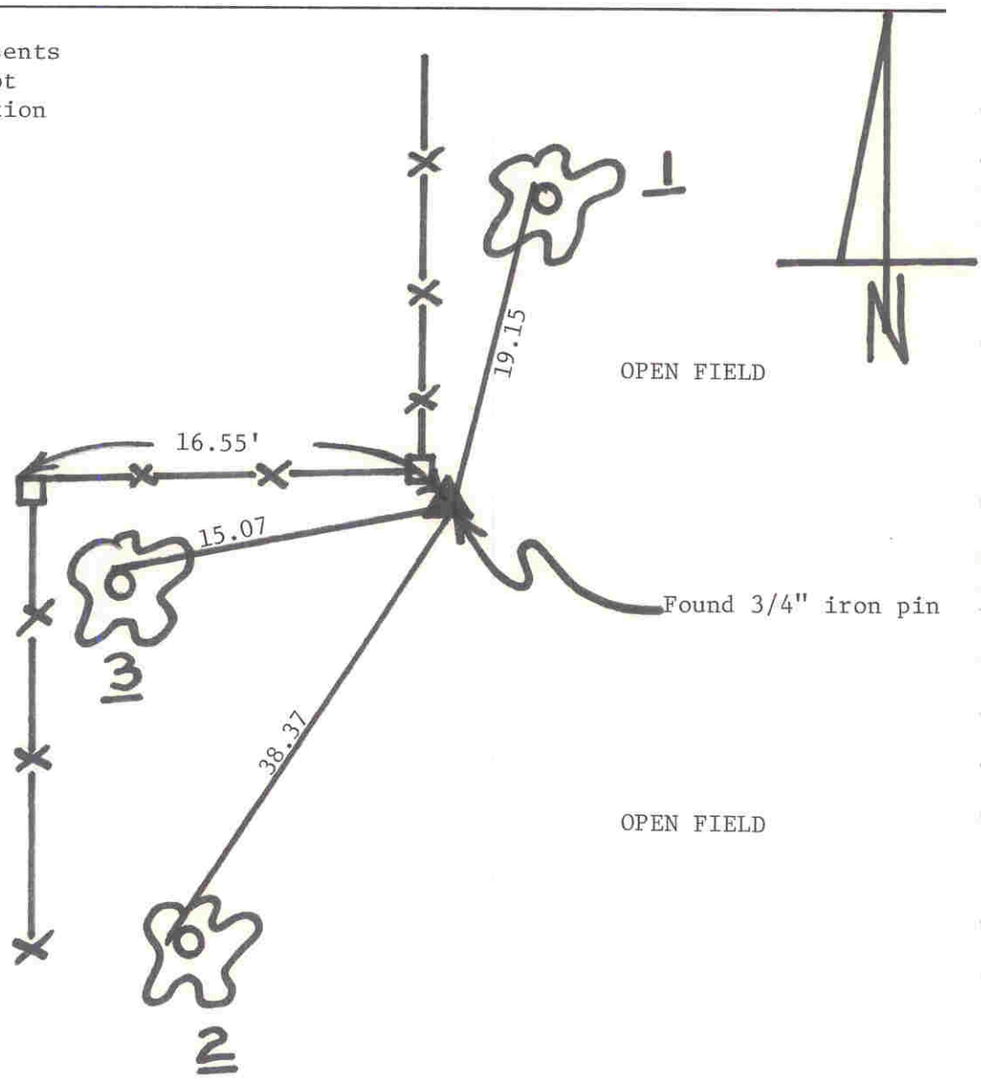

SX722518

REFERENCE	DISTANCE	DESCRIPTION
1	19.15	Hex bolt in washer 6" up on W-side of 10" Walnut Tree.
2	38.37	Road nail in W-side of Triple Tree 20" up
3	15.07	Hex bolt in washer N-side of 12" Oak Tree; 15" up
4	16.55	1/2" steel rebar