OFFICE OF THE MARION COUNTY SURVEYOR
SECTION RECORD CORNER
SECTION 32 TOWNSHIP 17 RANGE 2
DATE: 3-31-05
PARTY CHIEF: Wilcoxen
CREW:
TYPE OF MARKER: See Note:
METHOD OF ESTABLISHMENT: County: 11-8-99

Note: Fd concrete monument with rod w/ "SS 1938" inscribed on it.

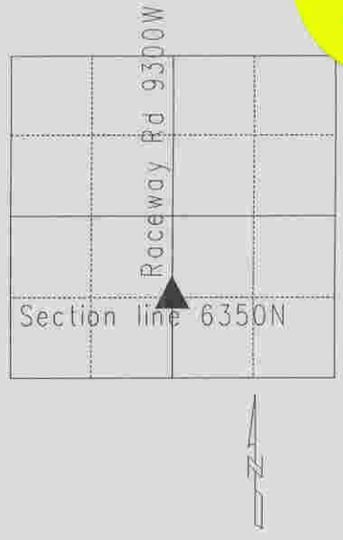

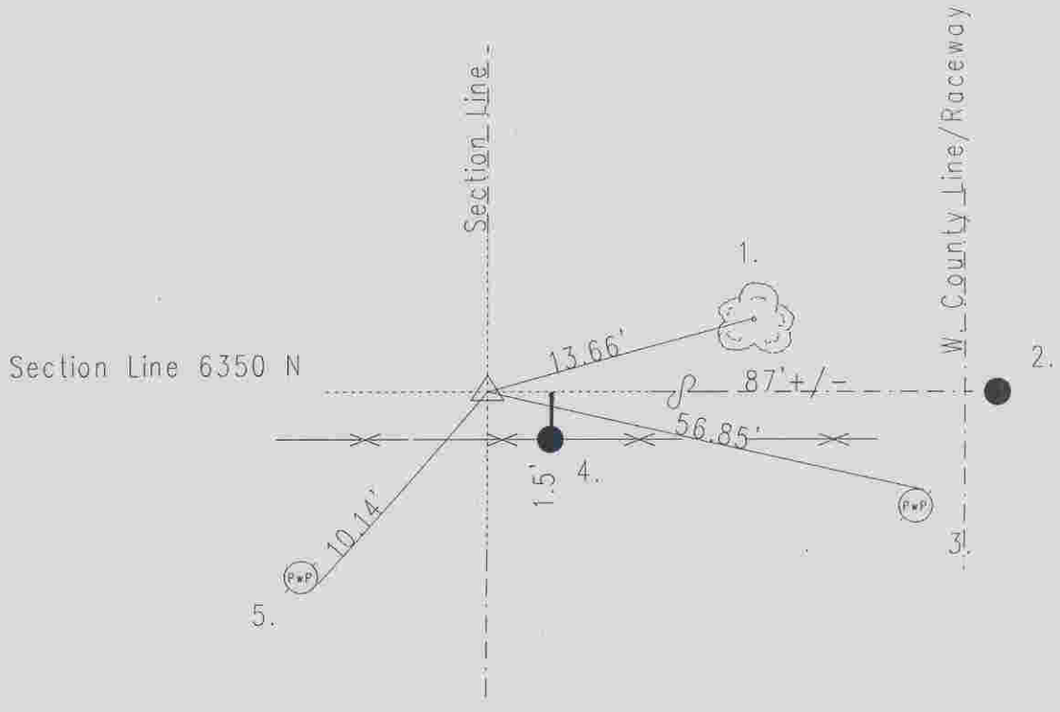

17023221

REF.	DISTANCE	DESCRIPTION
1.	13.66'	Mag nail S 15" tree 20"up
2.	87'+/-	Due F to MCSO capped rebar
3.	56.85'	Mag nail N PwP#52-288 60"up
4.	1.5'	Distance between section line & fence line
5.	10.14'	PK nail F PwP#44-287 A 12"up