OFFICE OF THE MARION COUNTY SURVEYOR
SECTION RECORD CORNER
SECTION 36 TOWNSHIP 17 RANGE 2
DATE: ~~---6-2-2000-~~ 4-18-05
PARTY CHIEF: Wilcoxen
CREW:
TYPE OF MARKER: Stone found
METHOD OF ESTABLISHMENT: County: 3-29-84

IN. S.P.C. E ZONE, NAD 83
NAME: 17023605
N: 513753.5555(m)
E: 50062.8224(m)

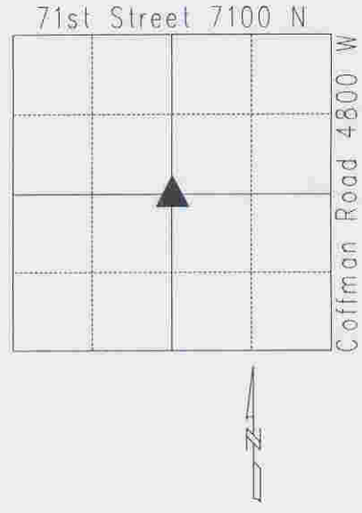

THIS CORNER POSITION REPRESENTS A "TITLE" CORNER AND MAY NOT NECESSARILY REPRESENT THE POSITION BASED ON RECORD CORNERS.

Behind house #6534
Cross Key Drive

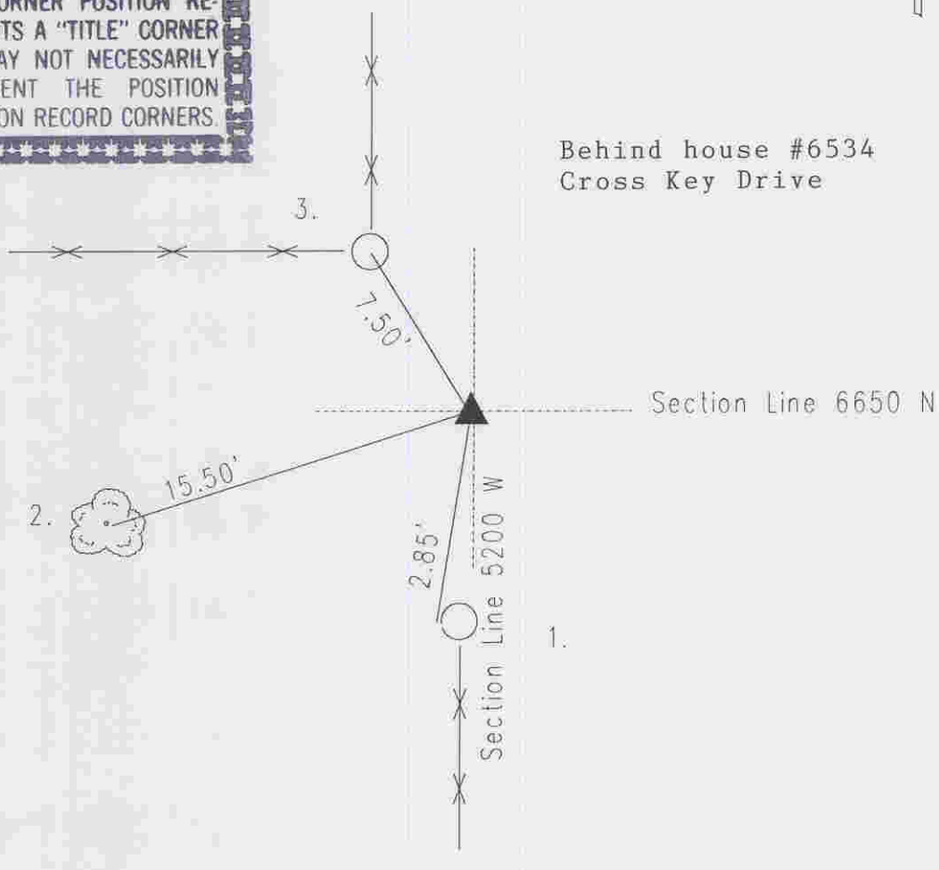

SC 723605

REF.	DISTANCE	DESCRIPTION
1.	2.85'	Mag nail w/brass washer W fence post 2"up
2.	15.50'	Mag nail w/brass washer S triple ash 72"up
3.	7.50'	Center of steel corner fence post :Pike HighSchool property