OFFICE OF THE MARION COUNTY SURVEYOR
SECTION RECORD CORNER
SECTION 36 TOWNSHIP 17 RANGE 2
DATE: 8-25-05
PARTY CHIEF: Wilcoxen
CREW:
TYPE OF MARKER: Harrison
METHOD OF ESTABLISHMENT: County: 4-19-00

IN. S.P.C. E ZONE NAD '83
NAME: 17023609
N: 512953.0510(m)
E: 50863.2490(m)

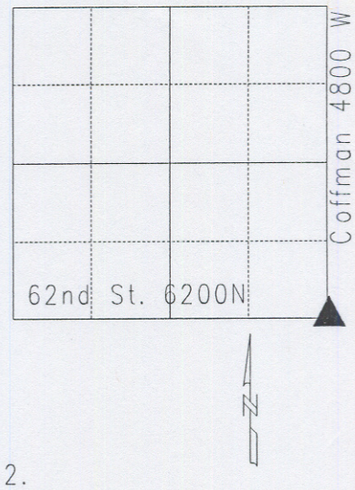

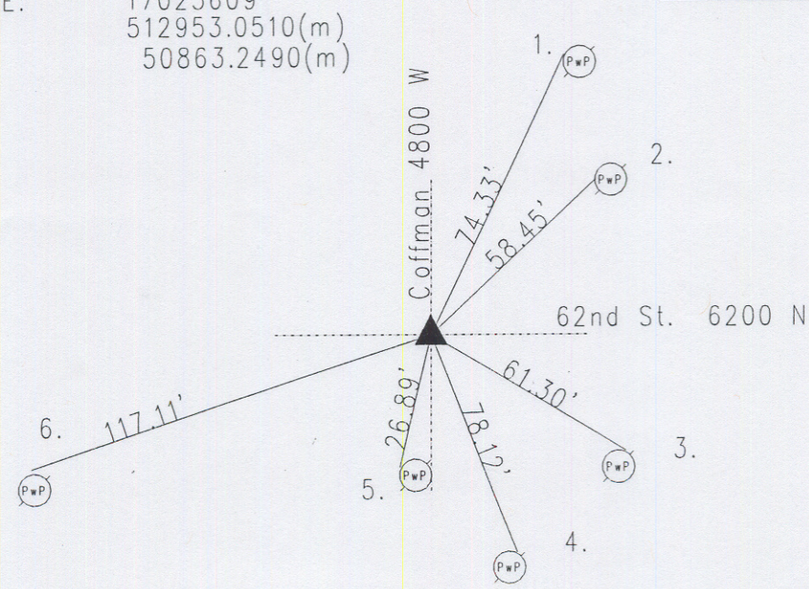

17023609 SE corner (same as SW 31-17-3)
CORNER HISTORY: Corner originally set as a post in 1821 by Wm. B. Laughlin with witness: 14" beech N 62 E 27 links, 12" dogwood S 47 E 22 links per Marion County Atlas pg. 4. A survey dated 11- 28 thru 30-1866 by Wm. P. Smith called just distances to a point per Pike Township Legal Survey Book pg. 37. A survey dated 2-14&15-1853 called witnesses to 'the' corner 20" elm S 16 W 51 links, 18" beech S 49 ½ E 62 links per Pike Township Legal Survey Book pg. 45. Reference dated 10-3-1961 by G. Schmidt called the corner as a road nail over stone. Old tie card (no name or date) called a brass plug in a concrete monument. Reference dated 5-27-75 by miller called a square brass plug. Reference dated 10-5-94 by Kiste called same. Reference dated 4-19-00 by Wilcoxen called railroad spike over brass plug. Reference dated 8-24-05 by Wilcoxen called due to re-surfacing project dug and found 1" square 4" long brass plug in wooden form filled with concrete 12" down, no other points were found; set Harrison.

17023609

REF.	DISTANCE	DESCRIPTION
1.	74.33'	PK nail W PwP#1-297 A 8"up
2.	58.45'	PK nail W PwP#263-297 A
3.	61.30'	PK nail F PwP#6-297 B 24"up
4.	78.12'	PK nail NF PwP#284-297 B 24"up
5.	26.89'	Mag nail w/bw W light pole #73-297 B 8"up
6.	117.11'	PK nail NW PwP#5-297B 12"up