OFFICE OF THE MARION COUNTY SURVEYOR
SECTION RECORD CORNER
SECTION 15 TOWNSHIP 17 RANGE 3
DATE: 9-17-04
PARTY CHIEF: Wilcoxen
CREW:
TYPE OF MARKER: Harrison
METHOD OF ESTABLISHMENT: County: 7-16-99

IN. S.P.C. E ZONE NAD '83
NAME: 17031501
N: 519519.2130(m)
E: 55774.8450(m)

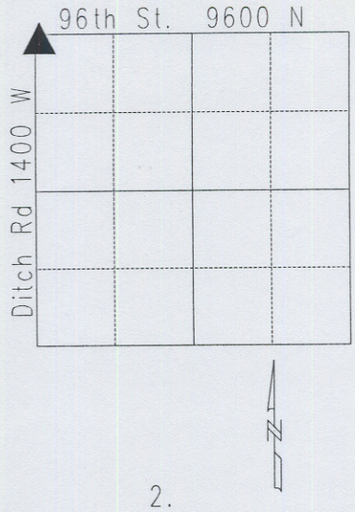

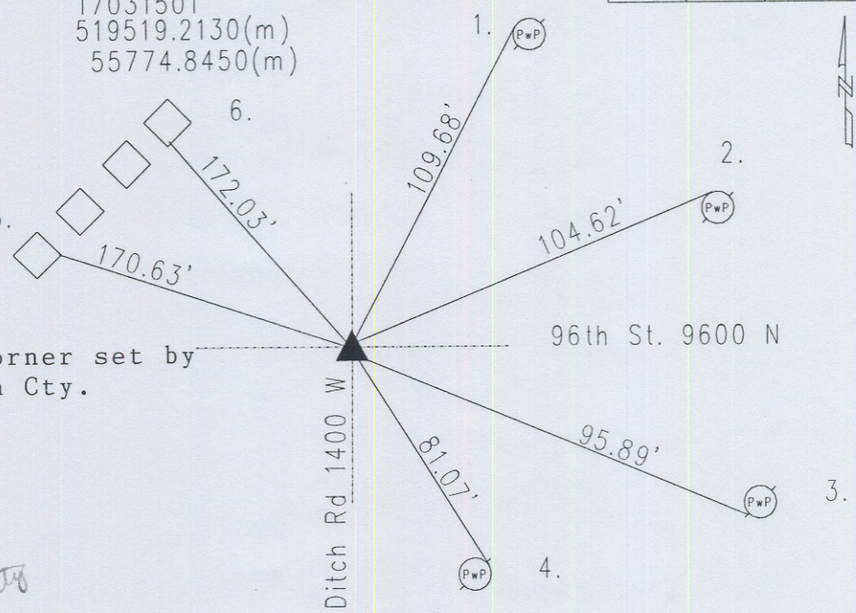

Note: Corner set by Hamilton Cty.

Hamilton County

17031501

REF.	DISTANCE	DESCRIPTION
1.	109.68'	Mag nail w/brass washer NW PwP#2-163 A 24"up
2.	104.62'	Mag nail w/brass washer N PwP#3-163 A 18"up
3.	95.89'	Mag nail w/brass washer SW PwP#411-163 B 18"up
4.	81.07'	Mag nail w/brass washer E PwP#410-163 B
5.	170.63'	Easterly corner of brick column
6.	172.03'	Southerly corner of brick column