OFFICE OF THE MARION COUNTY SURVEYOR
SECTION RECORD CORNER
SECTION 21 TOWNSHIP 17 RANGE 3
DATE: --~~9-25-99~~-- 10-10-04
PARTY CHIEF: Wilcoxen
CREW:
TYPE OF MARKER: Mag nail w/brass washer
METHOD OF ESTABLISHMENT: County: SEE NOTE:
2-25-76

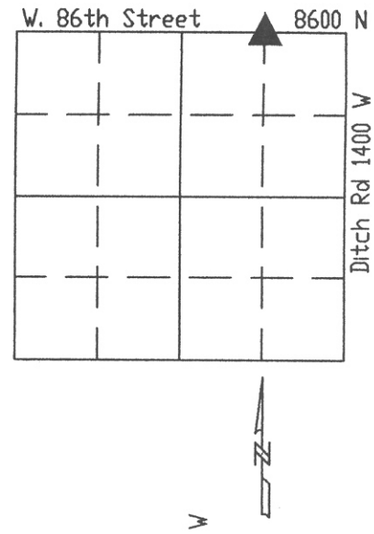

NOTE: This corner position represents a title corner and may not necessarily be in the position of the Record corner.

NOTE: Found mag nail 1.2' N & 0.35' W of our nail.

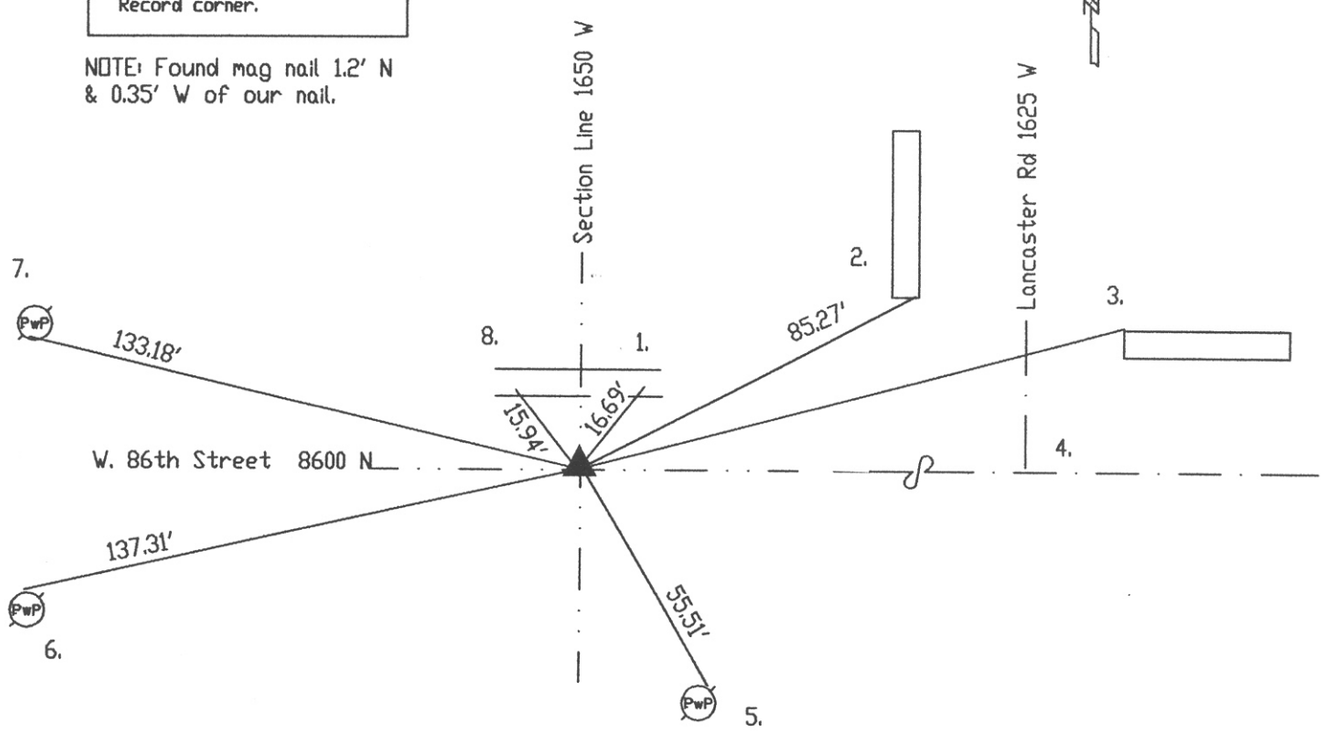

SX732111

REF.	DISTANCE	DESCRIPTION
1.	16.69'	Cut 'x' in median
2.	85.27'	SE corner of brick wall
3.	114.32'	NW corner of brick wall
4.	45'	Due E to C/L of Lancaster Road
5.	55.51'	Mag nail w/brass washer NE PwP#138-202 7"up
6.	137.31'	Mag nail w/brass washer N PwP#17-202B 12"up
7.	133.18'	Mag nail w/brass washer S PwP no# 4"up
8.	15.94'	Cut 'x' in median