OFFICE OF THE MARION COUNTY SURVEYOR
SECTION RECORD CORNER
SECTION 24 TOWNSHIP 17 RANGE 3
DATE: 3-23-99
PARTY CHIEF: Wilcoxen
CREW:
TYPE OF MARKER: Stone found at surface
METHOD OF ESTABLISHMENT: County: 2-27-76

NOTE: This corner position represents a title corner and may not necessarily be in the position of the Record corner.

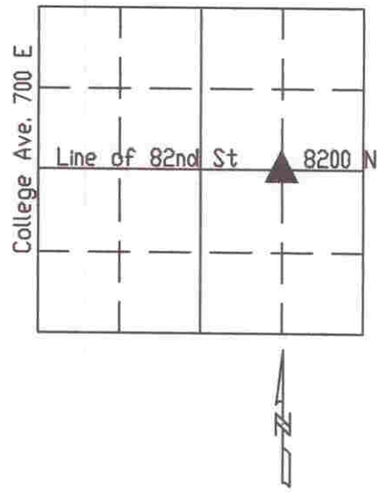

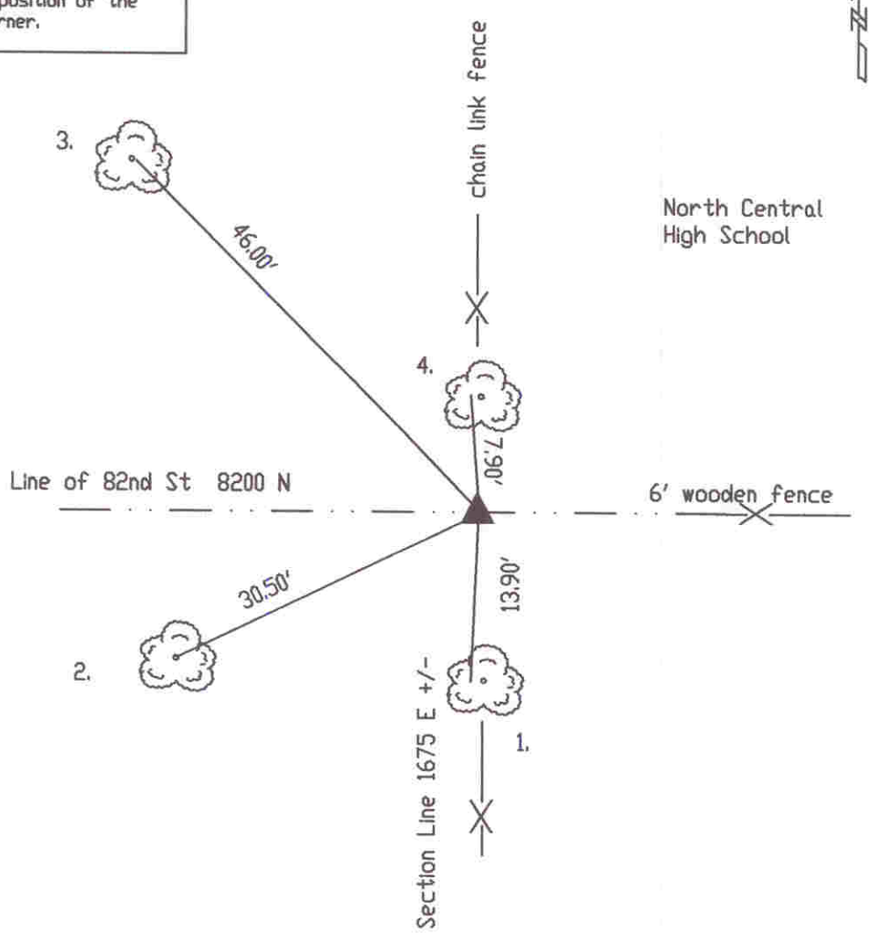

SX732418

REF.	DISTANCE	DESCRIPTION
1.	13.90'	Mag nail W 36" hackberry in spur root
2.	30.50'	Mag nail N 20" maple 12"up
3.	46.00'	Mag nail SE 20" maple spur root
4.	7.90'	Found railroad spike W 20" cherry 8"up