OFFICE OF THE MARION COUNTY SURVEYOR
SECTION RECORD CORNER
SECTION 27 TOWNSHIP 17 RANGE 3
DATE: 7-11-02
PARTY CHIEF: Wilcoxen
CREW:
TYPE OF MARKER: Harrison over stone 22" dn
METHOD OF ESTABLISHMENT: County: 8-11-97

IN. S.P.C. E ZONE NAD '83
NAME: 17032705
N: 515456.9489(m)
E: 56567.4548(m)

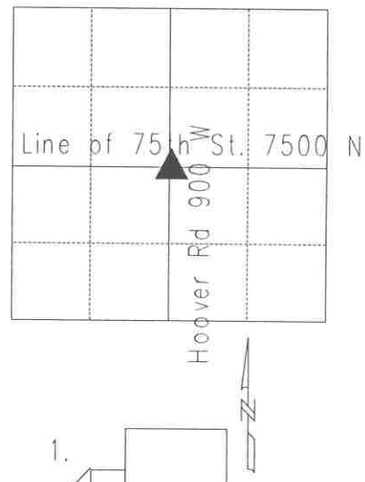

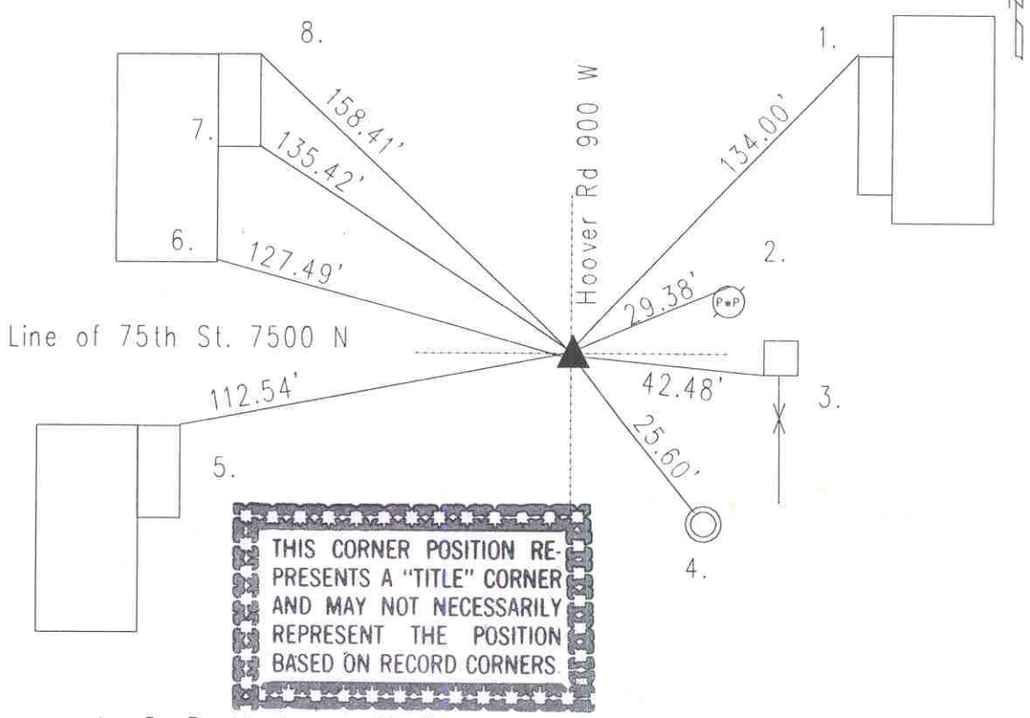

A survey by D. B. Hosbrook 1885 called no stone nor witness per Washington Township Legal Survey Book pg. 103. Burres 10-20-50 called a stone. Miller 3-11-76 called a railroad spike over stone. Gries 11-18-87 called the same. Wilcoxen 3-31-97 called the same. Excavated by Wilcoxen 8-5-97 and railroad spike found 6" down. Stone found 22" down. Harrison set on top of the stone. Re-tied 7-11-02 by wilcoxen.
17032705

REF.	DISTANCE	DESCRIPTION
1.	134.00'	NW corner of porch slab ADDRESS 7505 at brick
2.	29.38'	Mag nail N PwP#175-234 B 10"up
3.	42.48'	SW corne rof 1st brick column for apartments
4.	25.60'	Cut 'x' NW-rim of sewer manhole
5.	112.54'	NE corner of brick ADDRESS 7500
6.	127.49'	SE corner of stone/frame ADDRESS 7504
7.	135.42'	Easterly corner of ADDRESS 7504
8.	158.41'	NE corner "