OFFICE OF THE MARION COUNTY SURVEYOR
SECTION RECORD CORNER
SECTION 29 TOWNSHIP 17 RANGE 3
DATE: ~~7-11-02~~ ~~9-30-04~~ 9-21-05
PARTY CHIEF: Wilcoxen
CREW:
TYPE OF MARKER: Copperweld fd.
METHOD OF ESTABLISHMENT: County: 5-23-95

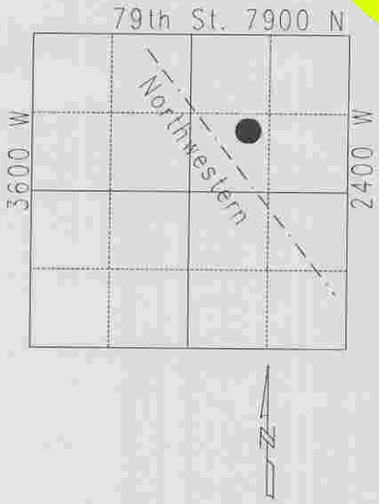

Enlarged detail

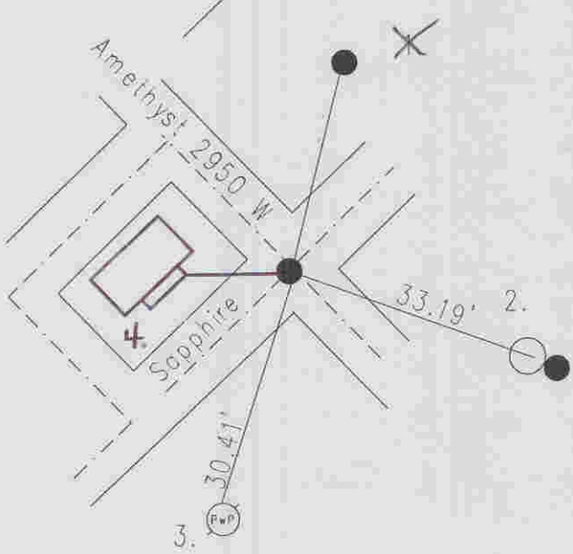

● are copperwelds

PX7329C

REF.	DISTANCE	DESCRIPTION
1.	~~36.17'~~	~~Capped rebar 'benchmark' survey~~
2.	33.19'	1" pipe & capped rebar side by side
3.	30.41'	Road nail N PwP no# 12"up
4.	70.91'	Top concrete porch slab Address 3102