OFFICE OF THE MARION COUNTY SURVEYOR
SECTION RECORD CORNER
SECTION 30 TOWNSHIP 17 RANGE 3
DATE: ~~9-25-99~~ 10-12-04
PARTY CHIEF: Wilcoxen
CREW:
TYPE OF MARKER: Brass plug found 4" down
METHOD OF ESTABLISHMENT: County: 5-23-95

NOTE: This corner position represents a title corner and may not necessarily be in the position of the Record corner.

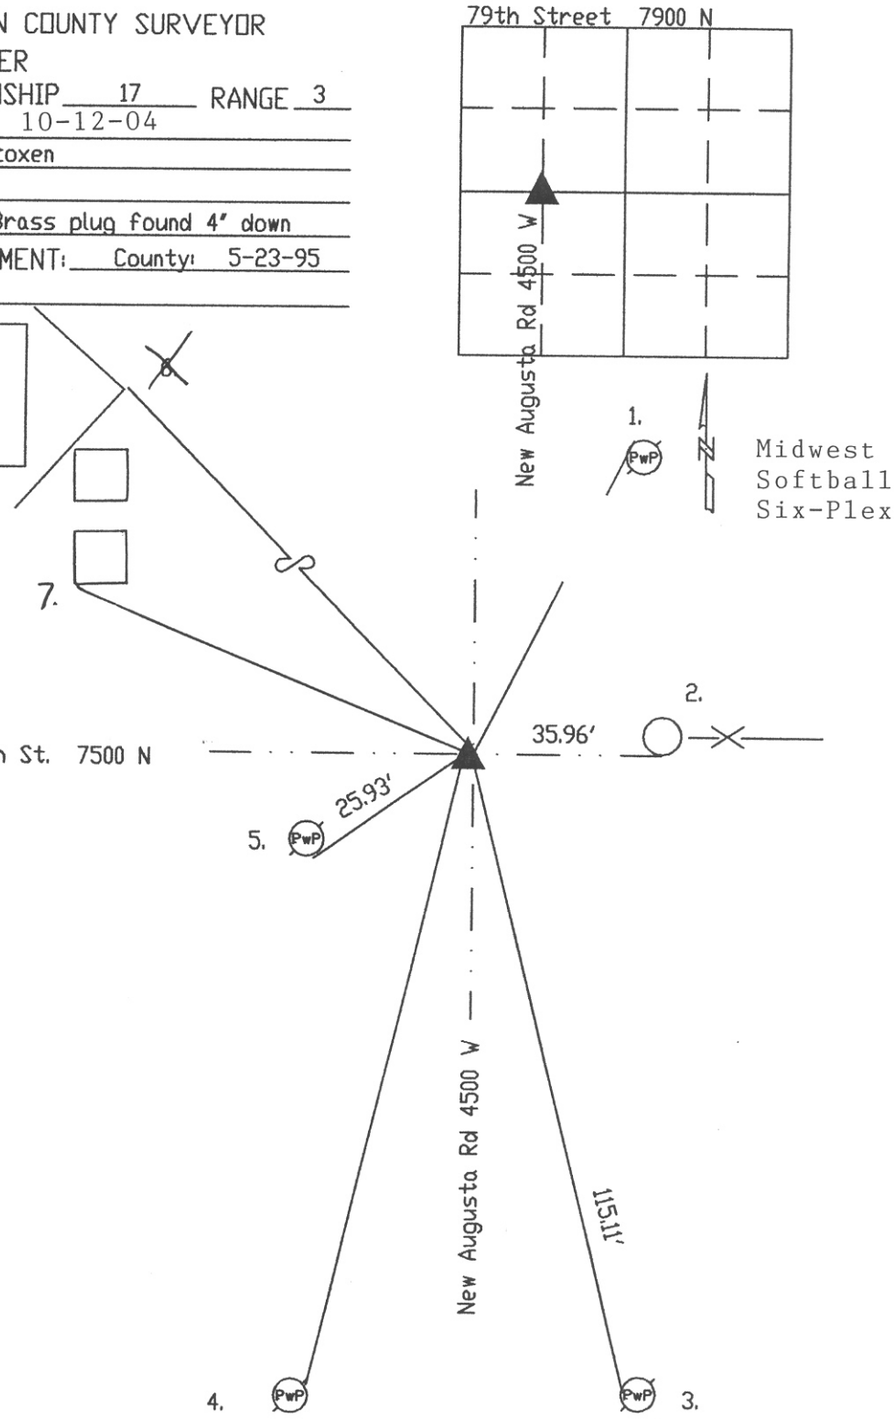

SX733017

REF.	DISTANCE	DESCRIPTION
1.	67.13'	PK nail NW PwP#14-228B 18"up
2.	35.96'	PK nail S fence post 15"up
3.	115.11'	Mag nail w/brass washer W PwP no# 10"up near ADDRESS 7505
4.	180.99	PK nail E PwP#110-257A 18"up
5.	25.93'	Road nail S PwP#111-257 36"up
6.	~~161.47'~~	~~Easterly corner of brick apartments~~
7.	132.03'	SW corner brick column