OFFICE OF THE MARION COUNTY SURVEYOR
SECTION RECORD CORNER
SECTION 33 TOWNSHIP 17 RANGE 3
DATE: ~~10-11-99~~ 11-10-03
PARTY CHIEF: Wilcoxen
CREW:
TYPE OF MARKER: Tack hub found
METHOD OF ESTABLISHMENT: County: 9-5-95

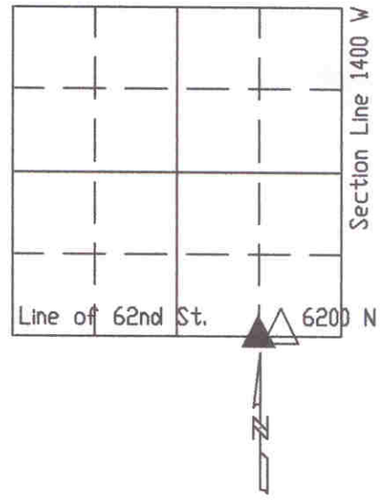

NOTE: This corner position represents a title corner and may not necessarily be in the position of the Record corner.

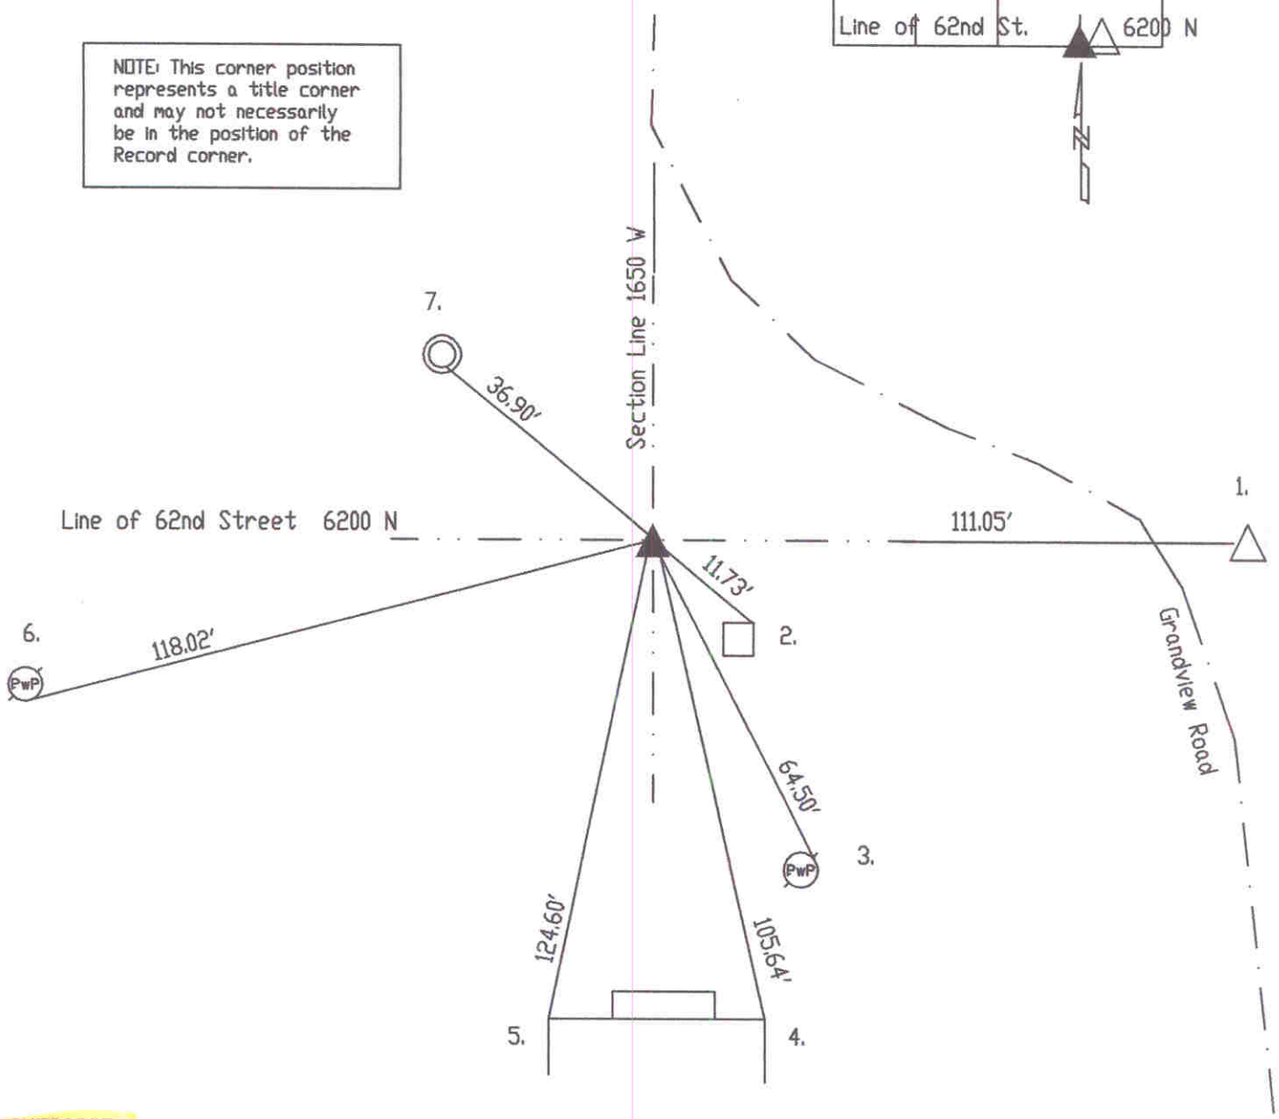

SX733325

REF.	DISTANCE	DESCRIPTION
1.	111.05'	Due E to N Q 3-16-3 (3/4" pin found)
2.	11.73'	Cut 'x' NE grade inlet
3.	64.50'	PK nail E PwP#195-302B 8"up
4.	105.64'	NE corner of brick ADDRESS 6142
5.	124.60'	NW corner "
6.	118.02'	Found Road nail S PwP#194-302B 12"up
7.	36.90'	Cut 'x' SE-rim of sewer manhole