OFFICE OF THE MARION COUNTY SURVEYOR
SECTION RECORD CORNER
SECTION 18 TOWNSHIP 17 RANGE 4
DATE: 7-14-99
PARTY CHIEF: Kiste
CREW:
TYPE OF MARKER: Railroad spike 2" down
METHOD OF ESTABLISHMENT: County: 2-2-93

IN. S.P.C. E ZONE, NAD 83
NAME: 17041804
N: 518702.4270(m)
E: 60656.6800(m)

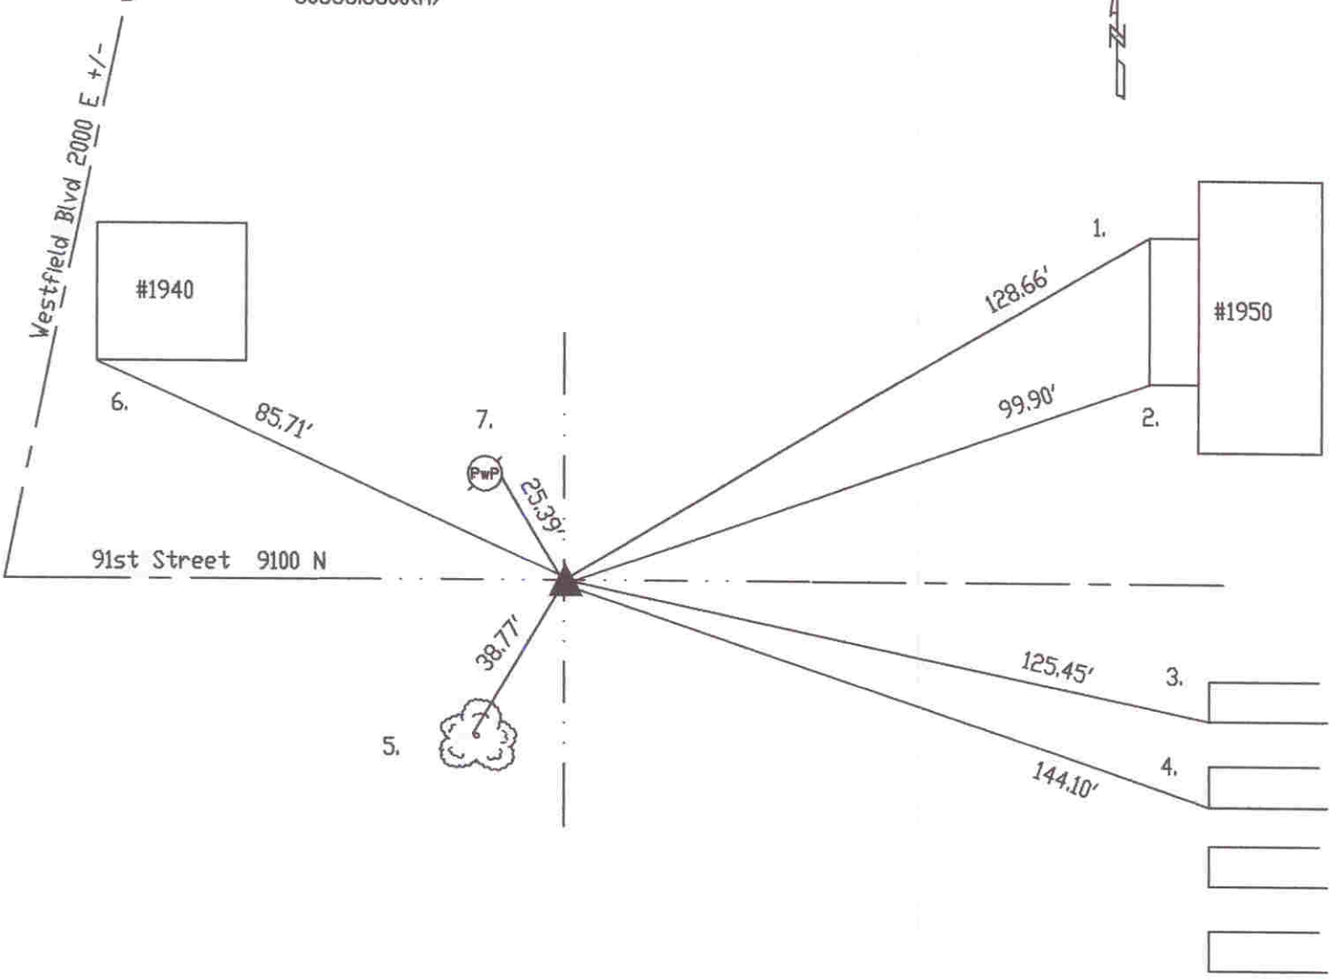

SC741804

REF.	DISTANCE	DESCRIPTION
1.	128.66'	NW corner of garage for house # 1950
2.	99.90'	SW corner "
3.	125.45'	SW concrete headwall at ground
4.	144.10'	SW concrete headwall at ground
5.	38.77'	Boat spike W 30" hackberry 15"up
6.	85.71'	SW corner of garage for house #1940 3rd brick up
7.	25.39'	PK nail E PwP#123-169B 24"up