OFFICE OF THE MARION COUNTY SURVEYOR
SECTION RECORD CORNER
SECTION 23 TOWNSHIP 17 RANGE 4
DATE: 11-7-05
PARTY CHIEF: Wilcoxen
CREW:
TYPE OF MARKER: Harrison w/steel post
METHOD OF ESTABLISHMENT: County: 3-7-00

IN. S.P.C. E ZONE NAD '83
NAME: 17042301
N: 517873.7140(m)
E: 67163.1310(m)

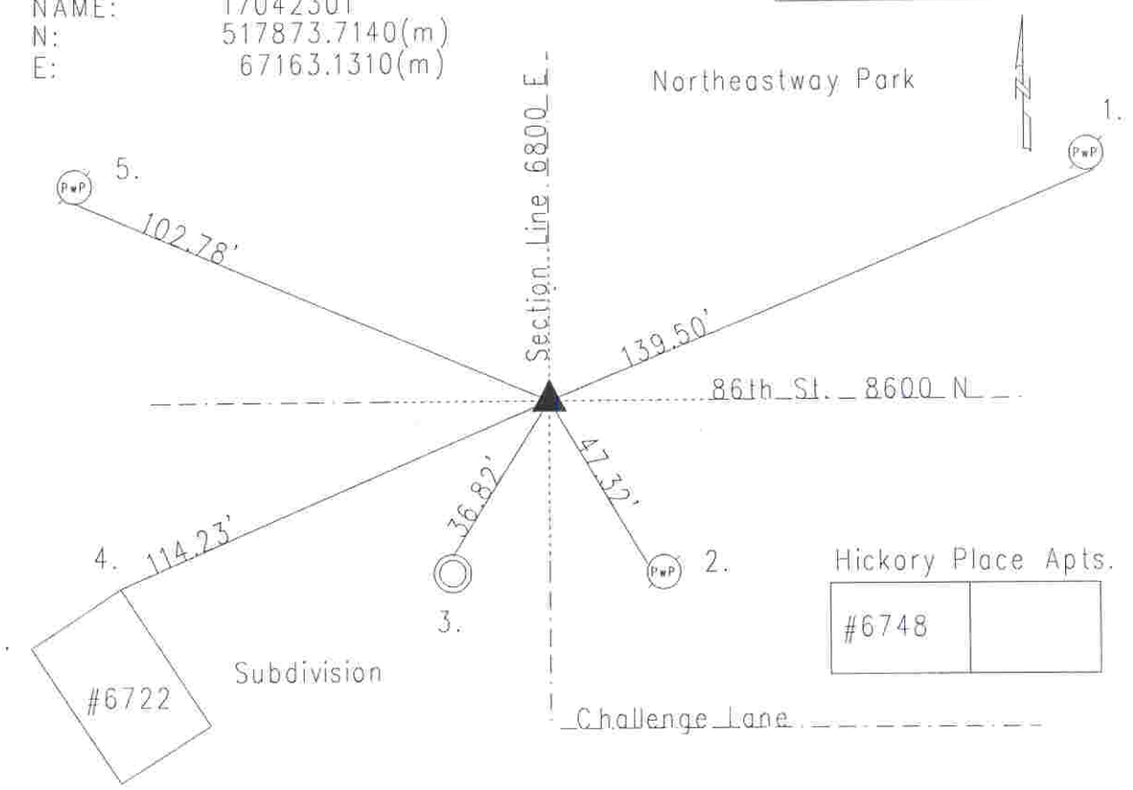

Original post set 1821 by Wm. B. Laughlin with witness: 18" ash N 50 E 23 links; 18" beech N 36 E 21 links per Marion County Altas pg. 12. NE corner of 22-17-4 calls for steel pin over stone, stone down 3". 10-7-70 NE corner calls for PK nail at surface with an iron pin slanting, 26" SW of top of stone. Ties dated 4-19-76 called for a stone. Excavated 8-8-86 stone found 3" down, under iron pin. Harrison set. Re-tied 8-30-91 by Wilcoxen. Re-tied 3-7-00 by Wilcoxen. Re-tied 11-7-05 by wilcoxen.

17042301

REF.	DISTANCE	DESCRIPTION
1.	139.50'	PK nail S PwP#38-217A 24"up
2.	47.32'	PK nail W PwP#101-217B 36"up
3.	36.82'	Cut 'x' W-side of manhole
4.	114.23'	Northerly corner of siding ADDRESS 6722
5.	102.78'	PK nail S PwP#39-217A 36"up