OFFICE OF THE MARION COUNTY SURVEYOR
SECTION RECORD CORNER
SECTION 30 TOWNSHIP 17 RANGE 4
DATE: 02-09-2000
PARTY CHIEF: Wilcoxen
CREW:
TYPE OF MARKER: Harrison
METHOD OF ESTABLISHMENT: County:

IN. S.P.C. E ZONE, NAD 83
NAME: 17043001
N: 516271.7009(m)
E: 60644.0944(m)

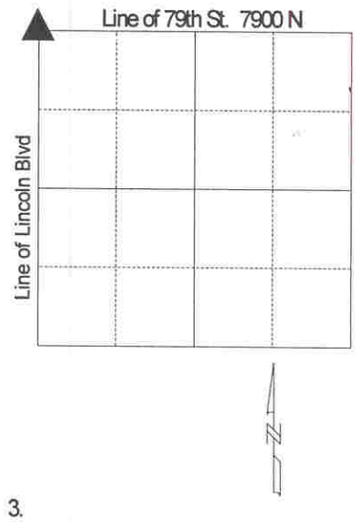

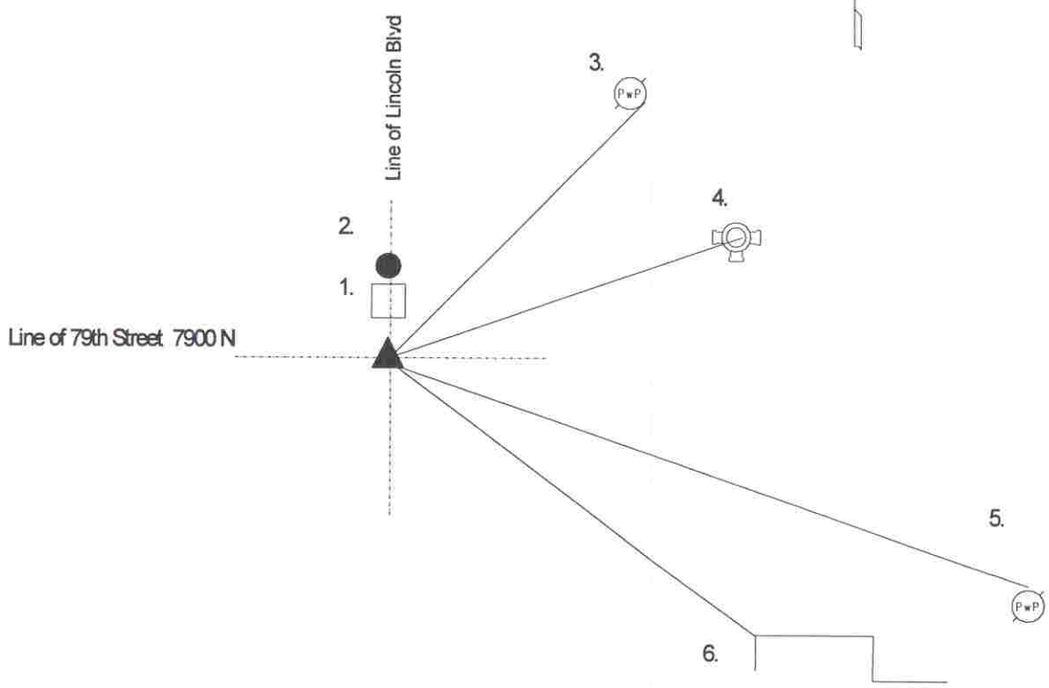

Original post set 1821 by Wm. B. Laughlin with witnesses: 48" Oak S 76 W 25 links, 14" Hackberry S 3 E 39 links per Marion County Atlas pg. 12. There is no reference to this corner in the Washington Township Legal Survey Book. This corner was excavated 12-14-87 and stone found, per P.I. Cripe survey and plat. Harrison set. Re-tied 2-09-00 by Wilcoxen.

HC743001

REF.	DISTANCE	DESCRIPTION
1.	1.9'	Due N to Rebar found
2.	5.9'	PK nail W side of fence post 10"up
3.	29.60'	PK nail SE PwP#404-239 6"up
4.	36.35'	Top nut of fire hydrant
5.	91.40'	PK nail N PwP#250-239 4"up
6.	80.10'	NE corner of house #2009 at brick garage