OFFICE OF THE MARION COUNTY SURVEYOR
SECTION RECORD CORNER
SECTION 32 TOWNSHIP 17 RANGE 4
DATE: ~~10-25-96~~ 10-30-03
PARTY CHIEF: Wilcoxen
CREW:
TYPE OF MARKER: C/L Harrison
METHOD OF ESTABLISHMENT: County: 8-20-87
'96 EDM

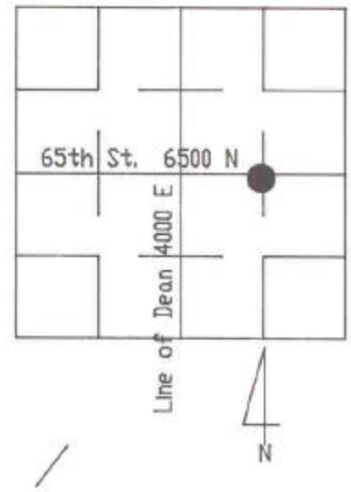

NOTE: This corner position represents a title corner and may not necessarily be in the position of the Record corner.

NOTE: Harrison was set as per hinge nail fd 6' dn in 1943 Legal Survey. No other point was fd in the old concrete road.

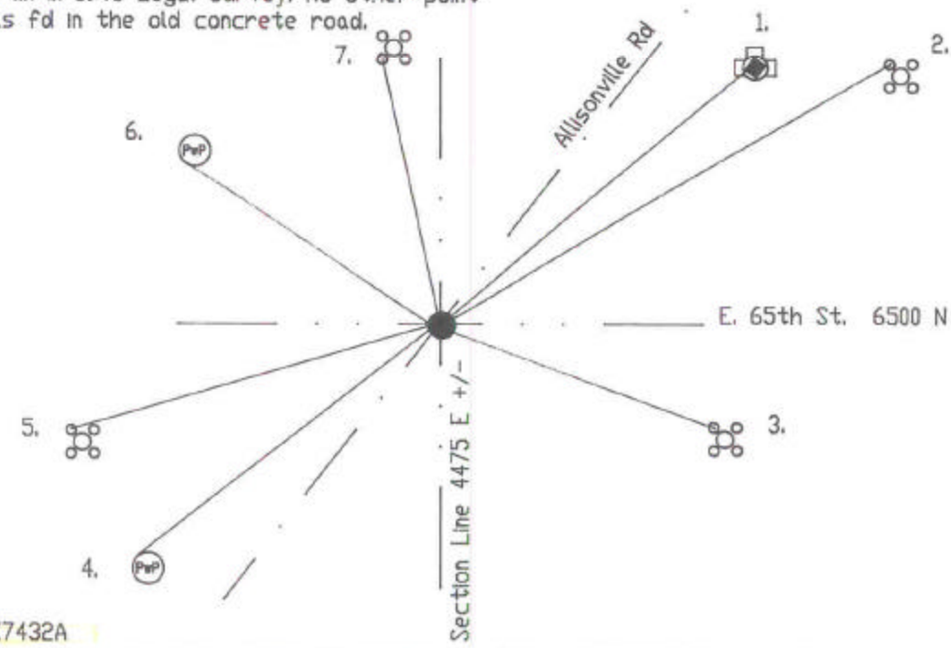

PX7432A

REF.	DISTANCE	DESCRIPTION
1.	65.11'	Top nut
2.	74.69'	'x' NW bolt alum. pole
3.	54.51'	'x' NW bolt alum pole
4.	76.95'	PK NW PwP#662-312 48"up
5.	73.14'	'x' NW bolt alum. pole
6.	46.63'	PK SW PwP#1-273 30"up
7.	52.02'	'x' SW bolt alum. pole